Const. Auth. 4659176544

# IREDELL COUNTY HEALTH DEPARTMENT

STATESVILLE 704-878-5305 MOORESVILLE 704-664-5281

## IMPROVEMENT PERMIT / CERTIFICATE OF COMPLETION / OPERATION PERMIT / EXISTING SYSTEM INSPECTION

PROPERTY DESCRIPTION NO. 24852 DATE 6/19/97 TAX MAP NO. pt. of 4EA12 Watershed: ☒ Yes ☐ No

OWNER OR CONTRACTOR Pruitt Dev. Co PHONE: Business _____ Home _____

ADDRESS 142 Stutts Rd Mooresville NC

LOCATION 21 N. to Sailwinds Tr. Whitewater Ln. on right

SUBDIVISION Windward Pt. BLOCK / SECTION _____ LOT # 3 LOT AREA 120'x175' SITE CLASS P.S. DESIGN FLOW 360 gpd L.T.A.R. .3

Septic Tank: 1000 Gallons; STB 1018 Date 11/10/98

Pump Tank: _____ Gallons; PT _____ Date _____

Pump Make: _____ Model _____ Serial No. _____

Nitrification Field: No Fields 1 Square Feet 900' Linear Feet 300'

No Lines 3 at 100' Trench Width 36" Max Trench Bottom Depth ~36" Gravel Depth N/A

☐ New System ☐ Repair System Type: I, II, III, IV, V, VI

System Description: Gravity - Plastic Chamb.

Repair System Description: Gravity - Modified

Maintenance Agreement Required: ☐ Yes ☒ No

☐ House/Mod. Home ☒ Mobile Home ☐ Business ☐ Other

No. Bedrooms 3 No. Bathrooms 2 No. Employees ____


☐ Slab ☒ Crawl Space ☐ Basement w/plumbing ☐ Basement wo/plumbing

Water Supply: ☒ Individual ☐ Community ☐ Public


Comments: * Install inspection ports near ends of each lateral

Comments: WELL NOT LOCATED - 2/26/98

**INITIAL SITE SKETCH** Scale 1:50'

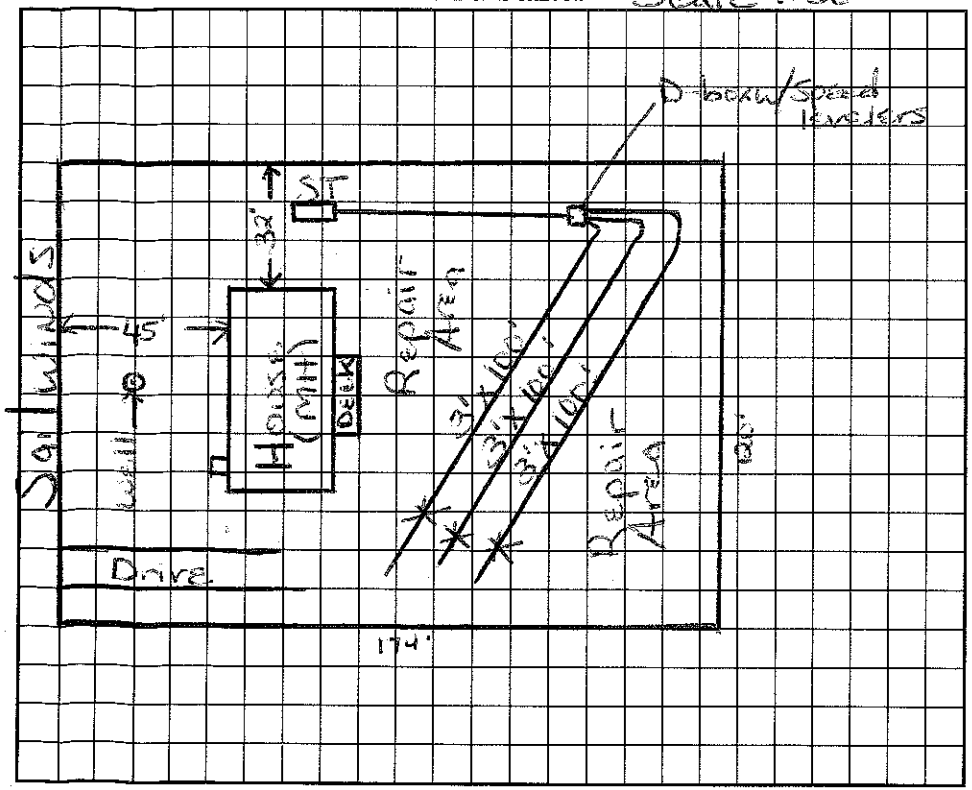


**AS BUILT SKETCH**

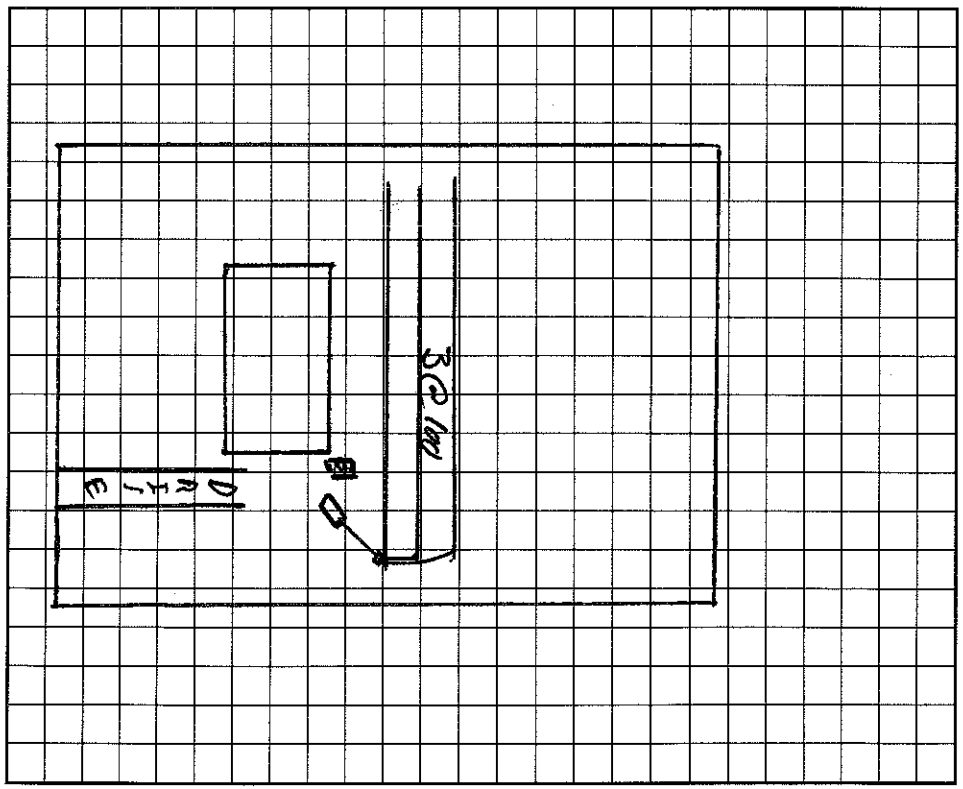


I understand that this permit can be suspended or revoked if any false information is supplied toward securing the permit/any unauthorized changes are made to the site/any unauthorized changes are made in the installation of the system. Improvement Permit is valid for 60 months from date of issuance.

Signed: _____

~~Construction Auth.~~ Improvement Permit by: Maria H. Hodgson date 6/19/97

Existing System Inspection by: Maria H. Hodgson date 6/19/97

Installed by: A-1 BACKHOE

Certificate of Completion by: _____ date _____

Operation Permit by: C. [illegible] date 2/26/98

HEALTH DEPT. COPY: WHITE INSPECTION COPY (FINAL): GREEN OWNER COPY (FINAL): YELLOW INSPECTION COPY (INITIAL): PINK OWNER COPY (INITIAL): GOLD