...TY HEALTH DEPARTMENT

AUTHORIZATION TO CONSTRUCT 4659177102 3:30pm

STATESVILLE 704-878-5305 MOORESVILLE 704-664-5281

...NT PERMIT / ~~CERTIFICATE OF COMPLETION~~ / OPERATION PERMIT / EXISTING SYSTEM INSPECTION

...RIPTION NO. 24923 DATE 5/16/97 TAX MAP NO. 4E A 12 Watershed: ☑ Yes ☐ No

...CONTRACTOR PRUITT DEVELOPMENT CO. PHONE: Business 575-8001 Home

...ESS 290 LAKEVIEW DR. MOORESVILLE NC 28115

LOCATION 21N - TL SAILWINDS - TL KEY WEST - 3RD ON RT

SUBDIVISION WINWARD PT. BLOCK / SECTION - LOT 74 LOT AREA 21,780 ft² SITE CLASS. PS DESIGN FLOW 360GPD L.T.A.R. .36GPD/FT

Septic Tank: 1000 Gallons; STB 821 Date 5/4/97

Pump Tank: ____ Gallons; PT ____ Date ____

Pump Make: ____ Model ____ Serial No. ____

Nitrification Field: No Fields 1 Square Feet 900 Linear Feet 300

No Lines 4@75' Trench Width 36" Max Trench Bottom Depth 36" Gravel Depth N/A

☑ New System ☐ Repair System Type: I, II, (III), IV, V, VI

System Description: GRAVITY CHAMBERED OR SIMILAR

Repair System Description: SAME

Maintenance Agreement Required: ☐ Yes ☑ No

☐ House/Mod. Home ☑ Mobile Home ☐ Business ☐ Other

No. Bedrooms 3 No. Bathrooms 2 No. Employees ____

☐ Slab ☑ Crawl Space ☐ Basement w/plumbing ☐ Basement wo/plumbing


Water Supply: ☑ Individual ☐ Community ☐ Public

Comments: 6/2/97 - upper line checked and okd - DS

Comments:

INITIAL SITE SKETCH

1"=40'

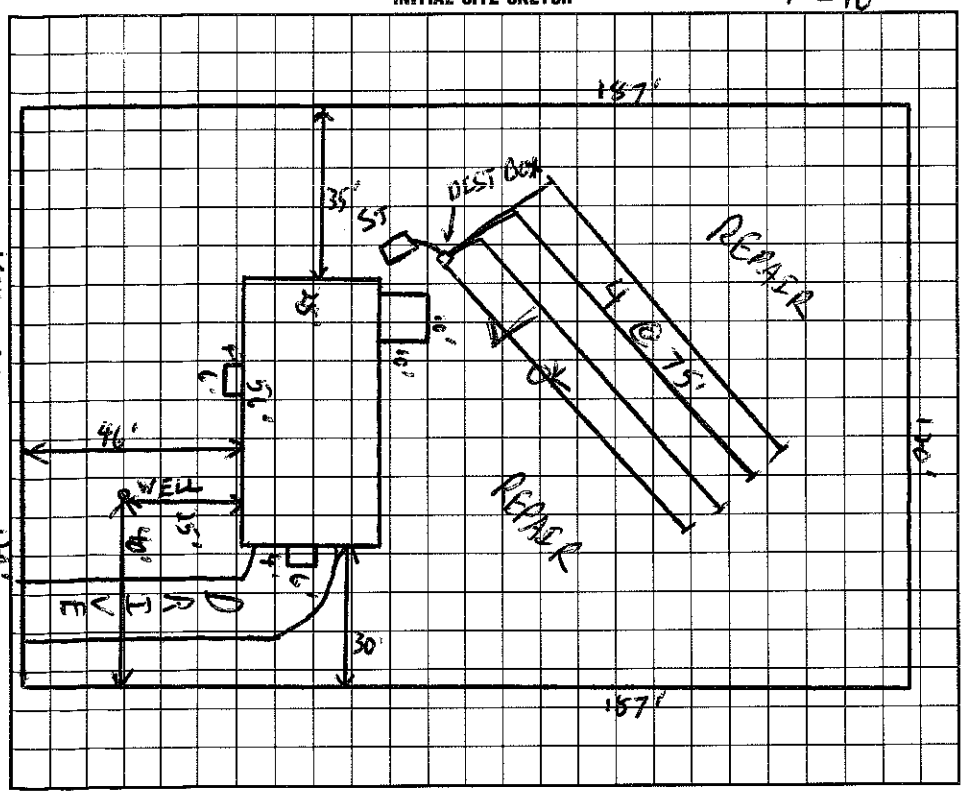

AS BUILT SKETCH

Same as Site Sketch

I understand that this permit can be suspended or revoked if any false information is supplied toward securing the permit/any unauthorized changes are made to the site/any unauthorized changes are made in the installation of the system. Improvement Permit is valid for 60 months from date of issuance.

Signed: ____

Improvement Permit by: C. Ray Teem date 5/16/97

AUTHORIZATION TO CONSTRUCT Existing System Inspection by: C. Ray Teem date 5/16/97

Installed by: G & M Enterprises

Certificate of Completion by: ____ date ____

Operation Permit by: C. Ray Teem date 6/3/97

HEALTH DEPT. COPY: WHITE INSPECTION COPY (FINAL): GREEN OWNER COPY (FINAL): YELLOW INSPECTION COPY (INITIAL): PINK OWNER COPY (INITIAL): GOLD