4100

IREDELL COUNTY HEALTH DEPARTMENT

STATESVILLE 704-878-5305 MOORESVILLE 704-664-5281

IMPROVEMENT PERMIT / ~~CERTIFICATE OF COMPLETION~~ / OPERATION PERMIT / EXISTING SYSTEM INSPECTION

PROPERTY DESCRIPTION NO. 25016 DATE April 19 '97 TAX MAP NO. part of 4EA12 4659178389 Watershed: ☑ Yes ☐ No

OWNER OR CONTRACTOR Pruett Dev. Co. PHONE: Business _____ Home _____

ADDRESS 142 Stutts Rd. Mooresville NC.

LOCATION 2 L N. TL Sailwinds TL Key West Ln. immediately on left

SUBDIVISION Windward Point BLOCK / SECTION _____ LOT 88 LOT AREA ± .5 ac SITE CLASS. 05 DESIGN FLOW 360 gpd L.T.A.R. .23

Septic Tank: 1000 Gallons; STB 868 Date 4-1-97
Pump Tank: N/A Gallons; PT _____ Date _____
Pump Make: _____ Model _____ Serial No. _____
Nitrification Field: No Fields 1 Square Feet 900 Linear Feet 300
No Lines 3 @ 100' Trench Width 36" Max Trench Bottom Depth 36" Gravel Depth N/A

☑ New System ☐ Repair System Type: I, II, III, IV, V, VI
System Description: Gravity plastic chambered
Repair System Description: 3 LP chambered
Maintenance Agreement Required: ☐ Yes ☑ No


☐ House/Mod. Home No. Bedrooms 3
☑ Mobile Home No. Bathrooms 2
☐ Business No. Employees ____
☐ Other _____
☐ Slab ☑ Crawl Space ☐ Basement w/plumbing ☐ Basement wo/plumbing

Water Supply: ☑ Individual ☐ Community ☐ Public


Comments:
Install inspection port on each chambered lateral ~3/4 way down. Not installed at time of inspection.
Installed ±3' from end. mp

Comments: Well >50' from Septic System
mp

INITIAL SITE SKETCH 1"=50'

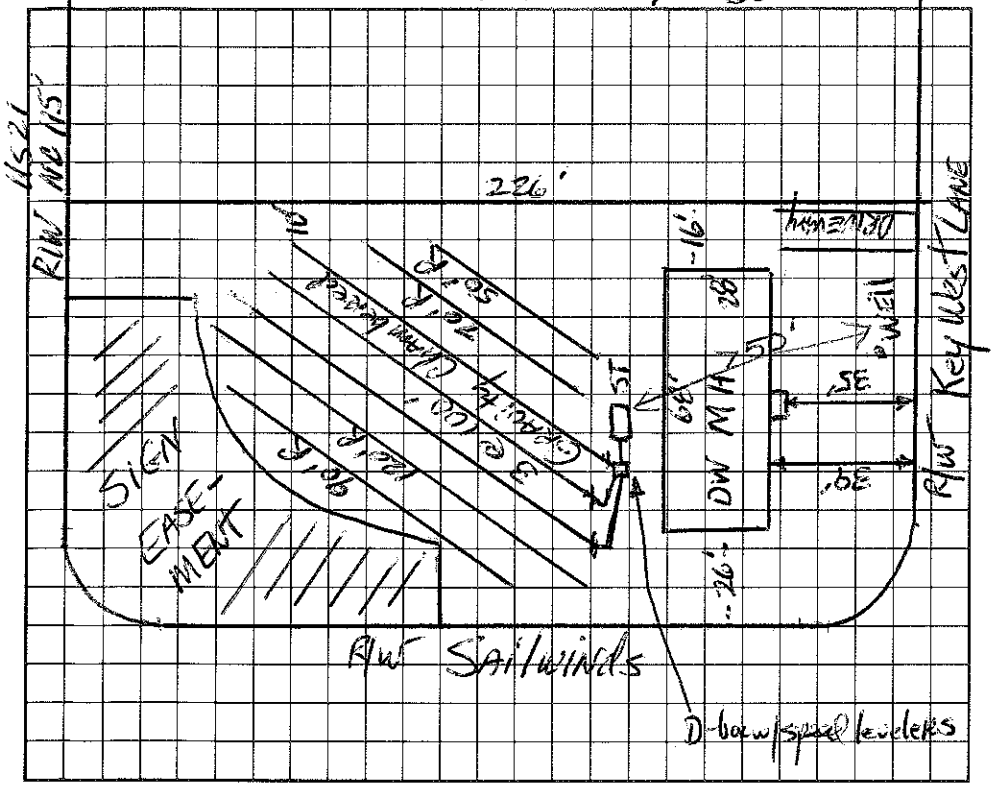

AS BUILT SKETCH

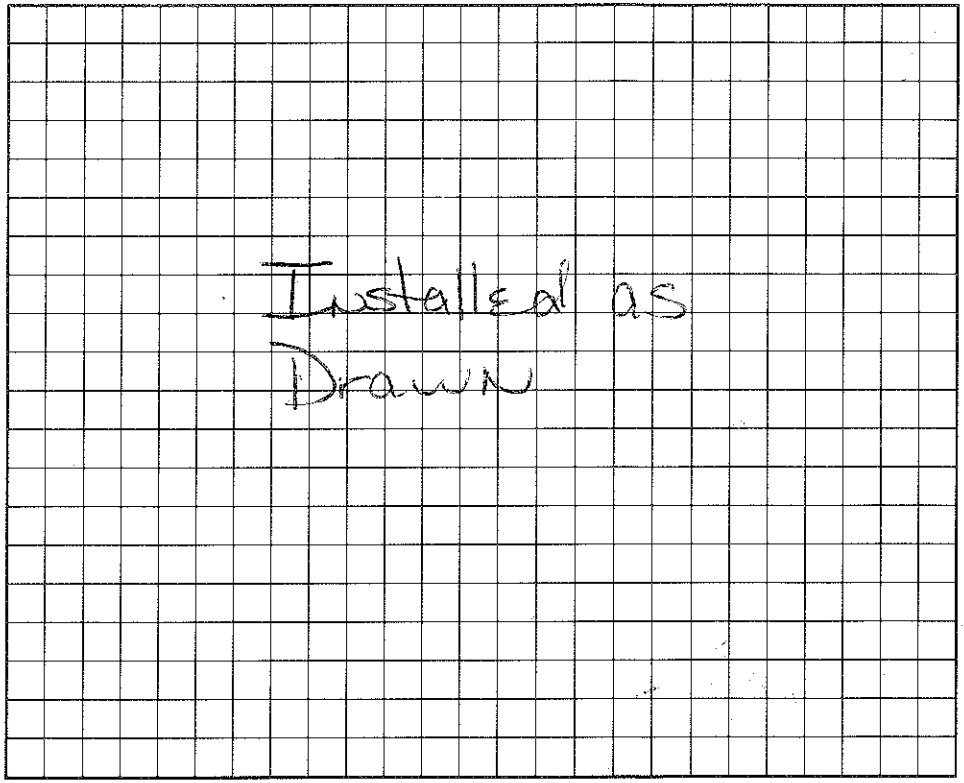

I understand that this permit can be suspended or revoked if any false information is supplied toward securing the permit/any unauthorized changes are made to the site/any unauthorized changes are made in the installation of the system.

Signed: *

Improvement Permit by: _____, RS date 4/19/97

~~Existing system inspection by:~~ Constructed Authorization _____, RS date 4/19/97

Installed by: G & M Enterprises

Certificate of Completion by: _____ date 5/5/97

Operation Permit by: _____ date _____

HEALTH DEPT. COPY: WHITE INSPECTION COPY (FINAL): GREEN OWNER COPY (FINAL): YELLOW INSPECTION COPY (INITIAL): PINK OWNER COPY (INITIAL): GOLD