...DELL COUNTY HEALTH DEPARTMENT

AUTHORIZATION TO CONSTRUCT 4659178528

STATESVILLE 704-878-5305 MOORESVILLE 704-664-5281

IMPROVEMENT PERMIT / ~~CERTIFICATE OF COMPLETION~~ / OPERATION PERMIT / EXISTING SYSTEM INSPECTIO

PROPERTY DESCRIPTION NO. 24851 DATE 11/19/97 TAX MAP NO. pt of 4EA12 Watershed: ☑ Yes ☐

OWNER OR CONTRACTOR PRUITT DEV. CO. PHONE: Business _____ Home _____

ADDRESS 13420 ROSE BLVD. W. HUNTERSVILLE

LOCATION 115-21N - TL SAILWINDS 2nd LOT ON RIGHT

SUBDIVISION WINNARD PT BLOCK / SECTION _____ LOT 1&2 LOT AREA _____ SITE CLASS. PS DESIGN FLOW 360 L.T.A.R. 1.5

Septic Tank: 1000 Gallons; STB 821 Date 10/21/97

Pump Tank: _____ Gallons; PT _____ Date _____

Pump Make: _____ Model _____ Serial No. _____

Nitrification Field: No Fields 1 Square Feet 900 Linear Feet 300

No Lines 3 @ 100' Trench Width 36" Max Trench Bottom Depth 36" Gravel Depth N/A

☑ New System ☐ Repair System Type: I, II, III, IV, V, VI

System Description: GRAVITY CHAMBERED OR HDS

Repair System Description: SAME

Maintenance Agreement Required: ☐ Yes ☑ No

☐ House/Mod. Home ☑ Mobile Home ☐ Business ☐ Other

No. Bedrooms 3 No. Bathrooms 2 No. Employees _____


☐ Slab ☑ Crawl Space ☐ Basement w/plumbing ☐ Basement wo/plumbing

Water Supply: ☑ Individual ☐ Community ☐ Public


Comments: LOT 1 & 2 COMBINED

Comments:

1"=50' **INITIAL SITE SKETCH**

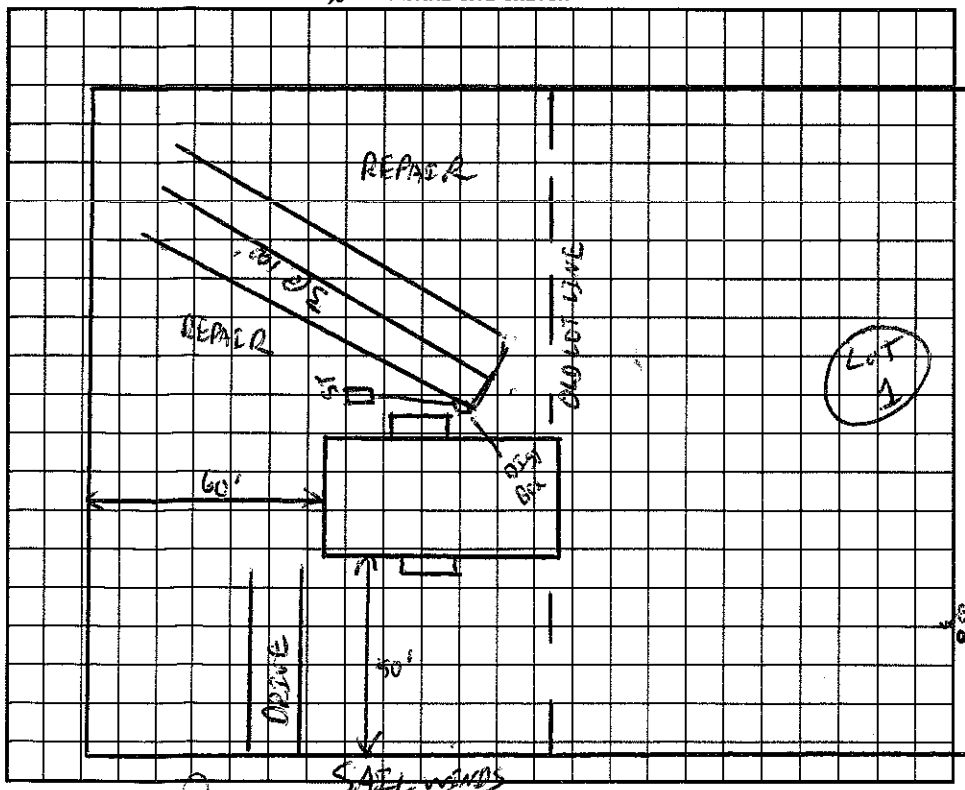

AS BUILT SKETCH

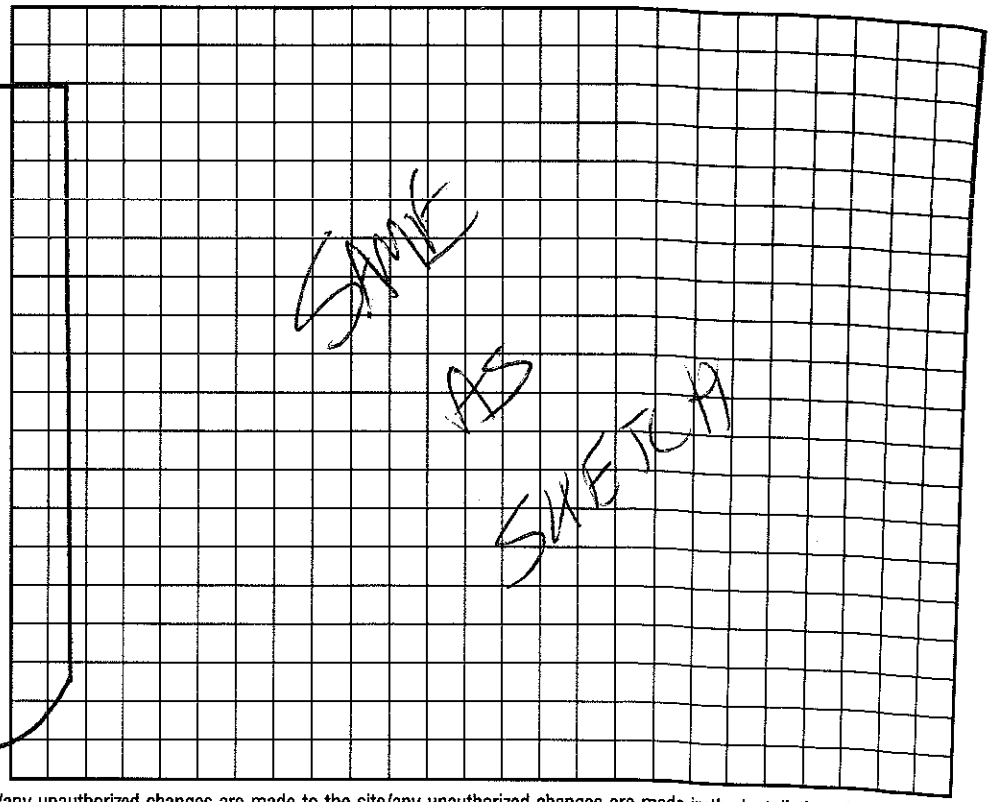

I understand that this permit can be suspended or revoked if any false information is supplied toward securing the permit/any unauthorized changes are made to the site/any unauthorized changes are made in the installation of the system. Improvement Permit is valid for 60 months from date of issuance.

Signed: Jason Wood Installed by: G&M ENTERPRISES

Improvement Permit by: C Ruby Foster RS date 11/19/97

AUTHORIZATION TO CONSTRUCT Existing System Inspection by: C Ruby Foster RS date 11/19/97

Certificate of Completion by: _____ date _____

Operation Permit by: C Ruby Foster date 11/20/97

HEALTH DEPT. COPY: WHITE INSPECTION COPY (FINAL): GREEN OWNER COPY (FINAL): YELLOW INSPECTION COPY (INITIAL): PINK OWNER COPY (INITIAL): GOLD