4659179040

DELL COUNTY HEALTH DEPARTMENT

STATESVILLE 704-878-5305 MOORESVILLE 704-664-5281

IMPROVEMENT PERMIT / CERTIFICATE OF COMPLETION / OPERATION PERMIT / EXISTING SYSTEM INSPECTION

PROPERTY DESCRIPTION NO. 25012 DATE 2-6-97 TAX MAP NO. 4E-A-12 Watershed: ☐ Yes ☐ No

OWNER OR CONTRACTOR Pruitt Development PHONE: Business 875 8001 Home

ADDRESS 290 Lakeview Dr. Mooresville N.C.

LOCATION US 21 Turn Sailwinds TL Keywest 5th lot left.

SUBDIVISION Windward Pt BLOCK / SECTION LOT 84 LOT AREA .53 acres SITE CLASS PS DESIGN FLOW 360 L.T.A.R. .3

Septic Tank: 1000 Gallons; STB 821 Date 5/14/97

Pump Tank: Gallons; PT Date

Pump Make: Model Serial No.

Nitrification Field: No Fields 1 Square Feet 1200 Linear Feet 400

No Lines 4 Trench Width 36" Max Trench Bottom Depth 36" Gravel Depth 12"

☒ New System ☐ Repair System Type: I, II, III, IV, V, VI

System Description: Conv. Gravity

Repair System Description: " "

Maintenance Agreement Required: ☐ Yes ☒ No

☐ House/Mod. Home No. Bedrooms 3

☒ Mobile Home No. Bathrooms 2

☐ Business No. Employees

☐ Other

☐ Slab ☒ Crawl Space ☐ Basement w/plumbing ☐ Basement wo/plumbing


Water Supply: ☒ Individual ☐ Community ☐ Public

Comments:


with speed levelers

Comments:

INITIAL SITE SKETCH

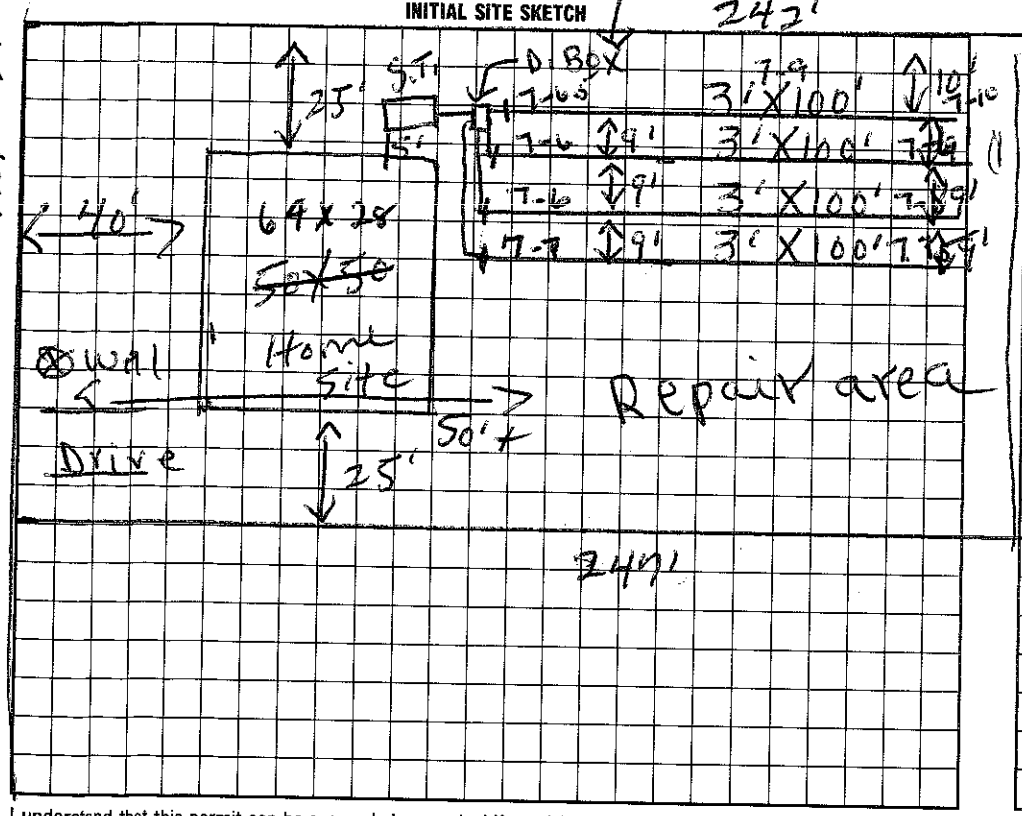

AS BUILT SKETCH

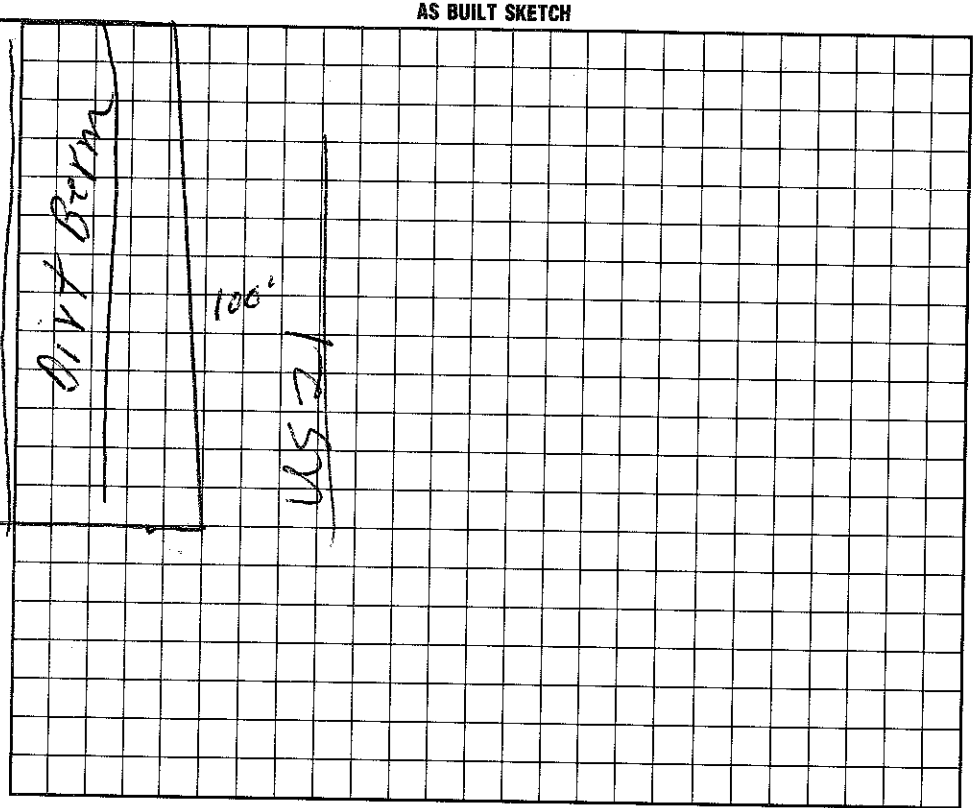

I understand that this permit can be suspended or revoked if any false information is supplied toward securing the permit/any unauthorized changes are made to the site/any unauthorized changes are made in the installation of the system. Improvement Permit is valid for 60 months from date of issuance.

Signed:

Improvement Permit by: T. C. Moore date 2-6-97

~~Existing system inspection by~~ T. C. Moore date 2-6-97

to Court.

Installed by: D+M Enterprises

Certificate of Completion by: Wesley Sparks R.S. date 6/10/97

Operation Permit by: Wesley Sparks R.S. date 6/10/97

HEALTH DEPT. COPY: WHITE INSPECTION COPY (FINAL): GREEN OWNER COPY (FINAL): YELLOW INSPECTION COPY (INITIAL): PINK OWNER COPY (INITIAL): GOLD