IREDELL COUNTY HEALTH DEPARTMENT

STATESVILLE 704-878-5305 MOORESVILLE 704-664-5281

IMPROVEMENT PERMIT / AUTHORIZATION TO CONSTRUCT / OPERATION PERMIT / EXISTING SYSTEM INSPECTION

PERMIT# 25013 PIN# 4EA12 4659 17 9130 DATE 4/16/98

OWNER OR CONTRACTOR Pruitt Development Co. PHONE: Business 875-0081 Home

ADDRESS 13420 Reese Blvd W Huntersville, NC. 28078

LOCATION 115-21N TL Sailwinds Road, TL to 4th on (L) on Key West Lane

SUBDIVISION WINWARD POINTE BLOCK / SECTION LOT 85 LOT AREA .53Ac SITE CLASS. PS DESIGN FLOW 360 L.T.A.R. .3

Septic Tank: 1000 Gallons; STB 1017 Date 7/23/98

Pump Tank: 1000 Gallons; PT 17 Date

Pump Make: HYDROMATIC Model SK 60A1 Serial No. 3/98

Nitrification Field: No Fields 1 Square Feet *900 Linear Feet *300

No Lines 4 Trench Width 36" Max Trench Bottom Depth 36" Gravel Depth SAND

[X] New System ☐ Repair System Type: I, II, [III], IV, V, VI

System Description: Presman-Ch. Plastics

Repair System Description: Same

Maintenance Agreement Required: ☐ Yes [X] No

[X] House/Mod. Home No. Bedrooms 3

☐ Mobile Home No. Bathrooms 2

☐ Business No. Employees

☐ Other


☐ Slab ☐ Crawl Space ☐ Basement w/plumbing ☐ Basement wo/plumbing

Water Supply: [X] Individual ☐ Public ☐ Community


Comments:/Conditions: * 25% reduction for Ch Plastics use

Comments:/Conditions: 5.75" Drawdown -

INITIAL SITE SKETCH

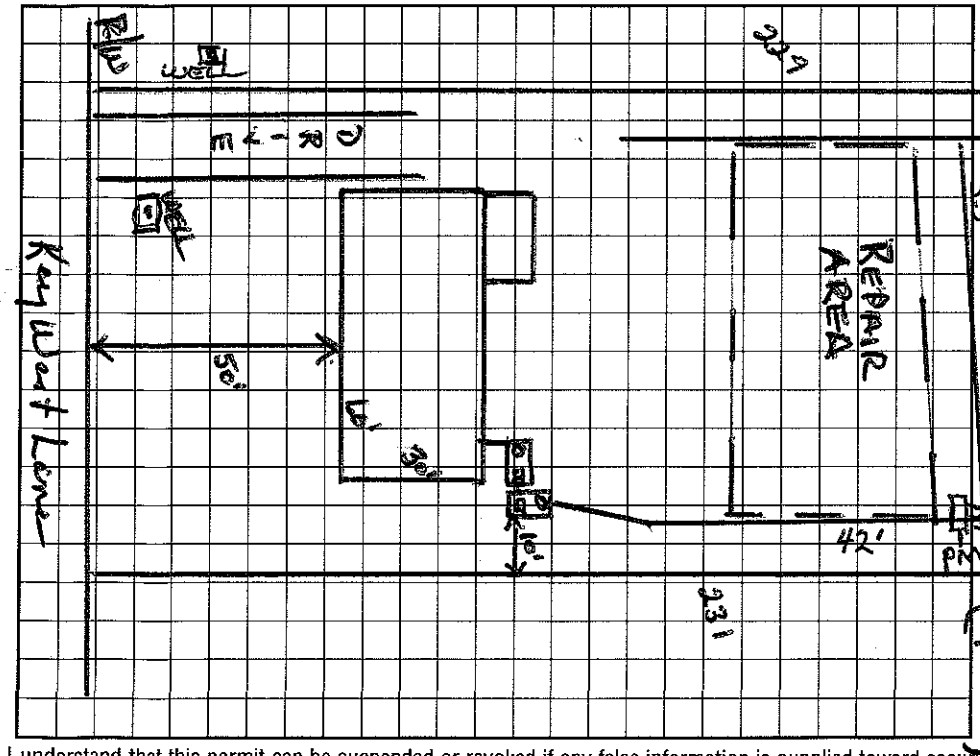

AS BUILT SKETCH

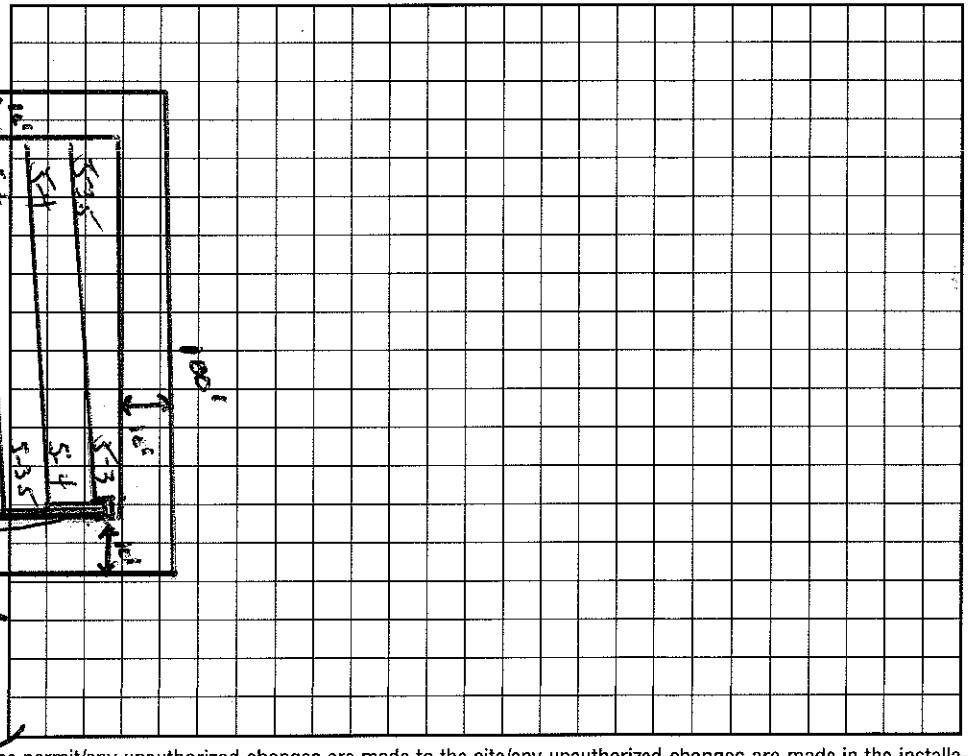

I understand that this permit can be suspended or revoked if any false information is supplied toward securing the permit/any unauthorized changes are made to the site/any unauthorized changes are made in the installation of the system. Improvement Permit with plat valid without expiration. Improvement Permit with site plan valid for sixty months. Authorization to Construct is valid for a period equal to that of Improvement Permit – not to exceed sixty months

Signed: * date 4-28-98

Improvement Permit by: Wesley Speaks RS. date 4/16/98

Authorization to Construct by: Wesley Speaks RS. date 4/16/98

Installed by: A-1 Backhoe

Operation Permit by: Wesley Speaks RS. date 10/29/98

Existing System Inspection by: date

HEALTH DEPT. COPY: WHITE INSPECTION COPY (FINAL): GREEN OWNER COPY (FINAL): YELLOW INSPECTION COPY (INITIAL): PINK OWNER COPY (INITIAL): GOLD