(10:00 - 10:30)

IREDELL COUNTY HEALTH DEPARTMENT

STATESVILLE 704-878-5305 MOORESVILLE 704-664-5281

IMPROVEMENT PERMIT / CERTIFICATE OF COMPLETION / OPERATION PERMIT / EXISTING SYSTEM INSPECTION

PROPERTY DESCRIPTION NO. 25014 DATE 8/18/97 TAX MAP NO. 4E-A-12 4659179210 Watershed: ☒ Yes ☐ No

OWNER OR CONTRACTOR Pruitt Dev. Co. PHONE: Business 1-800-722-3633 Home

ADDRESS 142 Stutts Rd. Mooresville, NC 28115

LOCATION Hwy 21 N to Sailwinds TL on Key West Ln 3rd lot on left

SUBDIVISION Lakewood Pt BLOCK / SECTION LOT 86 LOT AREA .53Acre SITE CLASS. PS DESIGN FLOW 360gpd L.T.A.R. .3

Septic Tank: 1600 Gallons; STB 821 Date 9/22/97

Pump Tank: Gallons; PT Date

Pump Make: Model Serial No.

Nitrification Field: No Fields 1 Square Feet 1200 Linear Feet 400

No Lines 5 @ 80' Trench Width 36" Max Trench Bottom Depth 24" Gravel Depth 12"

☒ New System ☐ Repair System Type: I, ☒ II, III, IV, V, VI

System Description: Gravity - Conventional

Repair System Description: Gravity - Plastic Chamb.

Maintenance Agreement Required: ☐ Yes ☐ No

☐ House/Mod. Home ☐ Mobile Home ☐ Business ☐ Other

No. Bedrooms No. Bathrooms No. Employees


☐ Slab ☒ Crawl Space ☐ Basement w/plumbing ☐ Basement wo/plumbing

Water Supply: ☒ Individual ☐ Community ☐ Public

Comments:

Comments:

INITIAL SITE SKETCH Scale 1:40

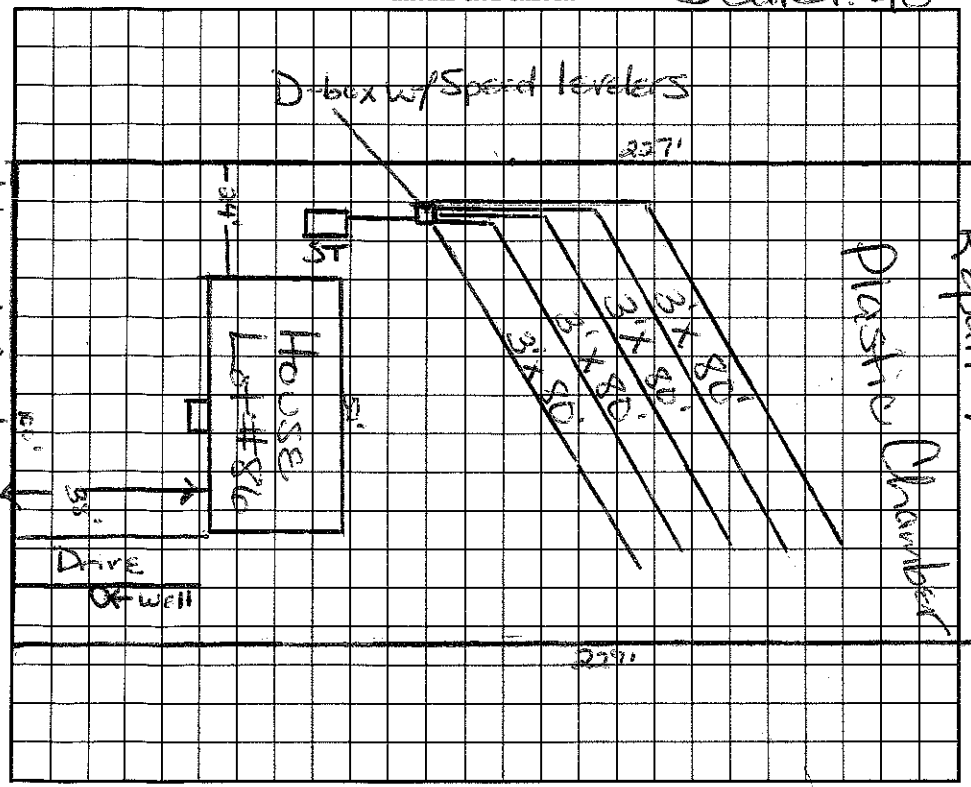

AS BUILT SKETCH

SAME AS SITE SKETCH

I understand that this permit can be suspended or revoked if any false information is supplied toward securing the permit/any unauthorized changes are made to the site/any unauthorized changes are made in the installation of the system. Improvement Permit is valid for 60 months from date of issuance.

Signed:

Improvement Permit by: Maria H.H. Dotson date 8/18/97

~~Existing System Inspection by:~~ Maria H.H. Dotson date 8/18/97

Installed by: C & M ENTERPRISES

Certificate of Completion by: date

Operation Permit by: C. [illegible] date 10/24/97

Construction

HEALTH DEPT. COPY: WHITE INSPECTION COPY (FINAL): GREEN OWNER COPY (FINAL): YELLOW INSPECTION COPY (INITIAL): PINK OWNER COPY (INITIAL): GOLD