4659179300

IREDELL COUNTY HEALTH DEPARTMENT

STATESVILLE 704-878-5305 MOORESVILLE 704-664-5281

IMPROVEMENT PERMIT / CERTIFICATE OF COMPLETION / OPERATION PERMIT / EXISTING SYSTEM INSPECTION

PROPERTY DESCRIPTION NO. 25015 DATE 8-18-97 TAX MAP NO. 4E A12 Watershed: ☒ Yes ☐ No

OWNER OR CONTRACTOR Pruitt Dev. Co. PHONE: Business 1-800 722-3633 Home 660-5900

ADDRESS 142 Stutts Rd. Mooresville NC 28115

LOCATION Hwy 21 N. to Sailwinds Tr on Key West Ln 2nd lot on left

SUBDIVISION Windward Pt BLOCK / SECTION ____ LOT 87 LOT AREA .52 Acre SITE CLASS. PS DESIGN FLOW 360 gpd L.T.A.R. .3

Septic Tank: 1000 Gallons; STB 1012 Date 9/8/25
Pump Tank: ____ Gallons; PT ____ Date ____
Pump Make: ____ Model ____ Serial No. ____
Nitrification Field: No Fields 1 Square Feet 1200 Linear Feet 400
No Lines 5 at 80' Trench Width 36" Max Trench Bottom Depth 24" Gravel Depth 12"

☒ New System ☐ Repair System Type: I, (II), III, IV, V, VI
System Description: Gravity - Conventional
Repair System Description Gravity - Plastic Chamb.
Maintenance Agreement Required: ☐ Yes ☒ No


☐ House/Mod. Home ☒ Mobile Home ☐ Business ☐ Other
No. Bedrooms 3 No. Bathrooms 2 No. Employees ____
☐ Slab ☒ Crawl Space ☐ Basement w/plumbing ☐ Basement wo/plumbing

Water Supply: ☒ Individual ☐ Community ☐ Public


Comments:

Comments:

INITIAL SITE SKETCH Scale 1:40

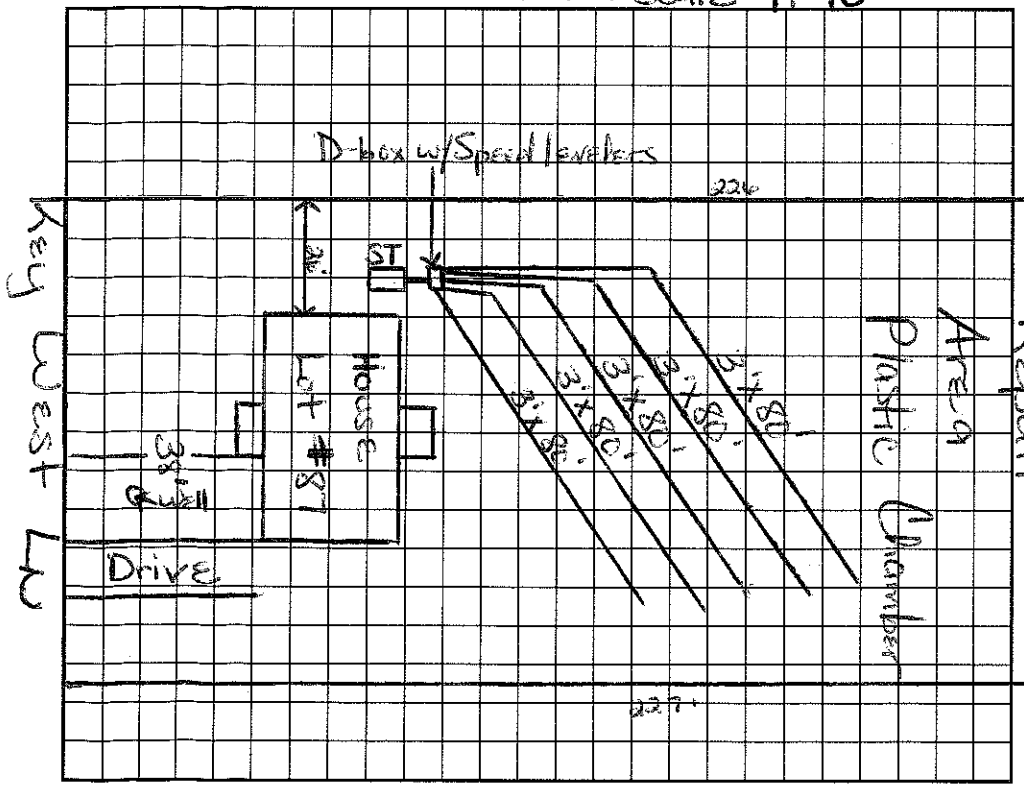

AS BUILT SKETCH

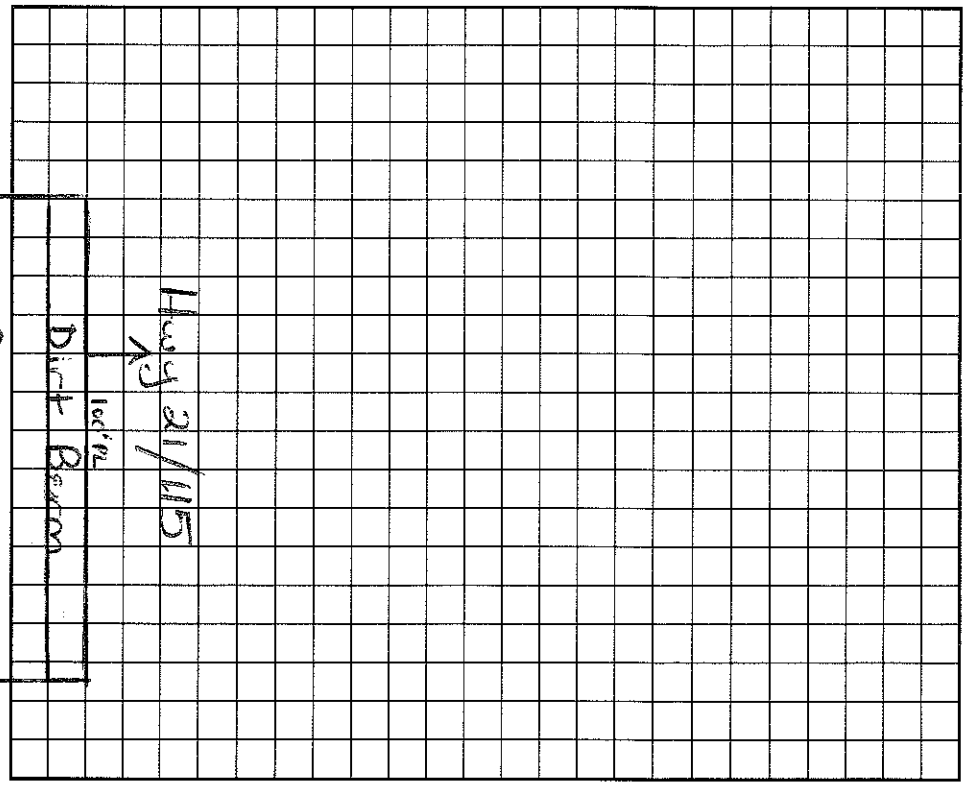

I understand that this permit can be suspended or revoked if any false information is supplied toward securing the permit/any unauthorized changes are made to the site/any unauthorized changes are made in the installation of the system. Improvement Permit is valid for 60 months from date of issuance.

Signed: ____

Improvement Permit by: Maria H.H. Dotson date 8/18/97

Existing System Inspection by: Maria H.H. Dotson date 8/18/97

Installed by: AJ BACKHOE

Certificate of Completion by: ____ date 6/16/98

Operation Permit by: Wesley Sparks R.S. date 6/18/98

Auth Construct

HEALTH DEPT. COPY: WHITE INSPECTION COPY (FINAL): GREEN OWNER COPY (FINAL): YELLOW INSPECTION COPY (INITIAL): PINK OWNER COPY (INITIAL): GOLD