IREDELL COUNTY HEALTH DEPARTMENT

STATESVILLE 704-878-5305 MOORESVILLE 704-664-5281

4659 21 1570

IMPROVEMENT PERMIT / CERTIFICATE OF COMPLETION / OPERATION PERMIT / EXISTING SYSTEM INSPECTION

PROPERTY DESCRIPTION NO. 20937 DATE 4/28/95 TAX MAP NO. 1R A 50 Watershed: ☐ Yes ☒ No

OWNER OR CONTRACTOR Ray Taylor PHONE: Business _____ Home 392-8609

ADDRESS 8228 Lakeshore Rd. Charlotte, NC. 28216

LOCATION Banfield Rd. on (L) below road

SUBDIVISION _____ BLOCK / SECTION _____ LOT _____ LOT AREA ~1.5 AC SITE CLASS. P DESIGN FLOW 360 L.T.A.R. .3

Septic Tank: 1000 Gallons; STB 794 Date 9/28/95

Pump Tank: _____ Gallons; PT _____ Date _____

Pump Make: _____ Model _____ Serial No. _____

Nitrification Field: No Fields 1 Square Feet 1200 Linear Feet 400

No Lines 3 Trench Width 36" Max Trench Bottom Depth 36" Gravel Depth 12"

☒ New System ☐ Repair System Type: I (II) III, IV, V, VI

System Description: CONV - DIST BOX

Repair System Description: Same

Maintenance Agreement Required: ☐ Yes ☒ No

☒ House/Mod. Home No. Bedrooms 3

☐ Mobile Home No. Bathrooms 3

☐ Business No. Employees ____

☐ Other _____


☐ Slab ☐ Crawl Space ☐ Basement w/plumbing ☐ Basement wo/plumbing

Water Supply: ☒ Individual ☐ Community ☐ Public


Comments:

Comments:

INITIAL SITE SKETCH

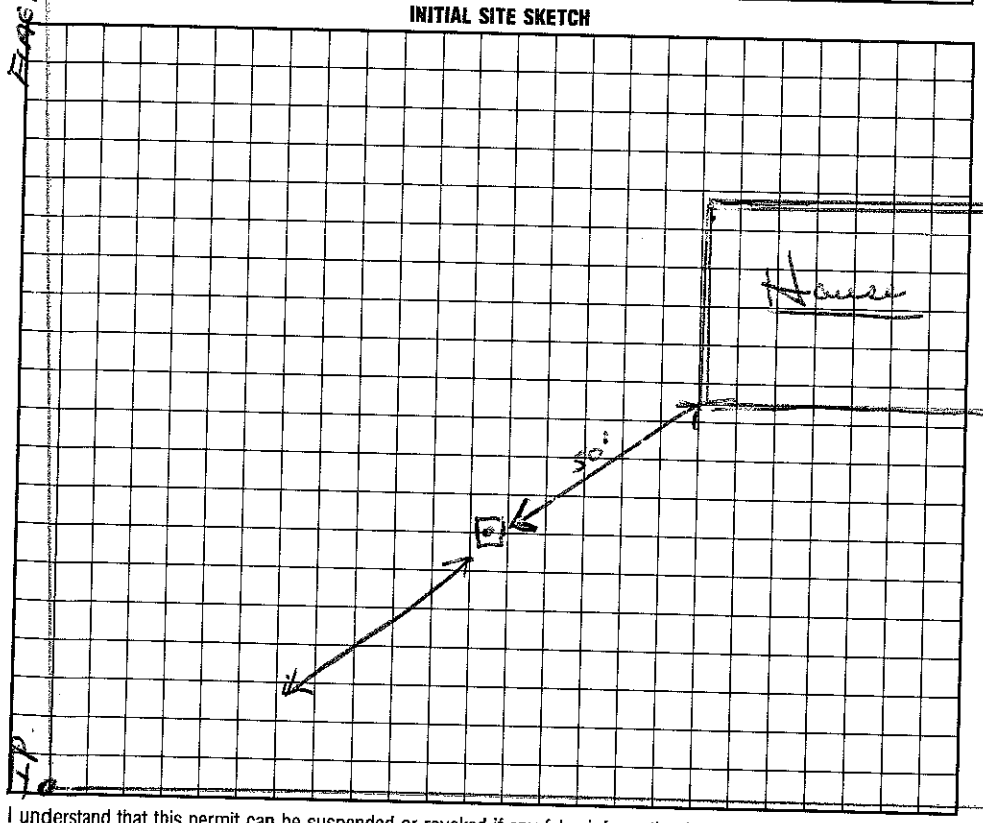

AS BUILT SKETCH

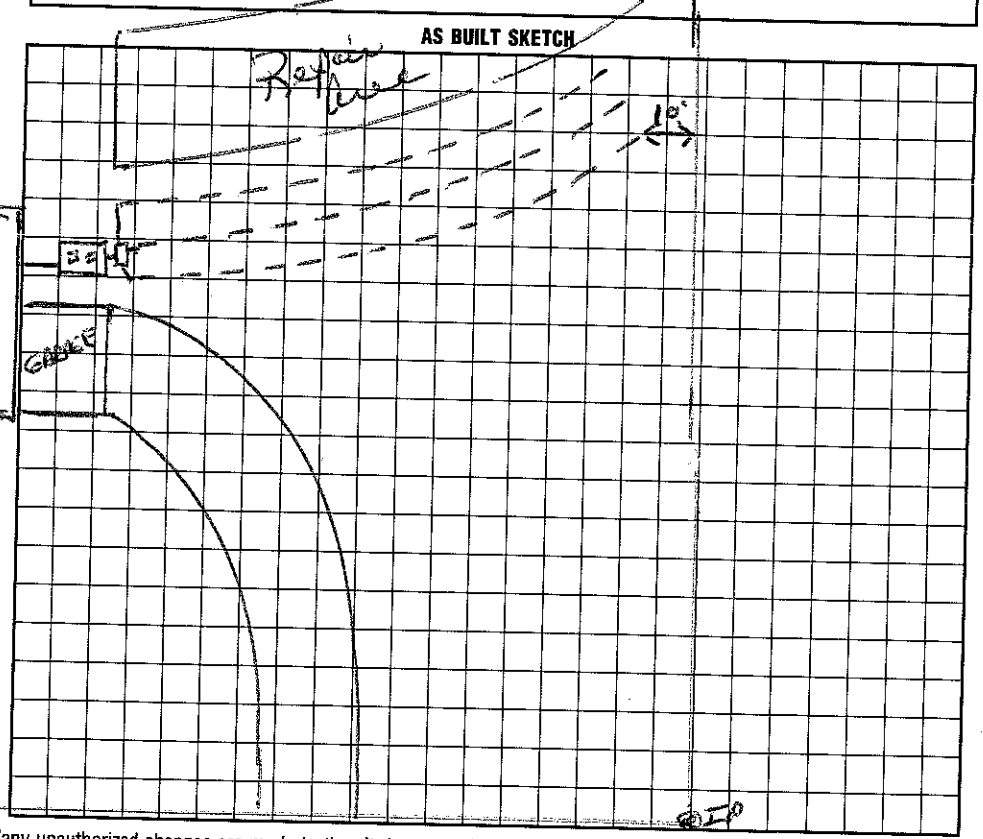

I understand that this permit can be suspended or revoked if any false information is supplied toward securing the permit/any unauthorized changes are made to the site/any unauthorized changes are made in the installation of the system. Improvement Permit is valid for 60 months from date of issuance.

Signed: Billy K. Taylor

Improvement Permit by: Wesley Sparks RS date 4/28/95

Existing System Inspection by: _____ date _____

Installed by: Dobson Grading Co. Banfield Rd.

Certificate of Completion by: Wesley Sparks R.S. date 11/17/95

Operation Permit by: Wesley Sparks R.S. date 11/17/95

HEALTH DEPT. COPY: WHITE INSPECTION COPY (FINAL): GREEN OWNER COPY (FINAL): YELLOW INSPECTION COPY (INITIAL): PINK OWNER COPY (INITIAL): GOLD