IREDELL COUNTY HEALTH DEPARTMENT

STATESVILLE 704-878-5305 — 130.00 Paid — MOORESVILLE 704-664-5281

IMPROVEMENT PERMIT / AUTHORIZATION TO CONSTRUCT / OPERATION PERMIT / EXISTING SYSTEM INSPECTION

PERMIT# 125764 PIN# ~~4659-23-2520~~ 4659231619 DATE 2/3/05

OWNER OR CONTRACTOR Audrey Hurst PHONE: Business 704-873-2101 Home 704-500-1425

ADDRESS [redacted] PO Box 6451

LOCATION 115/21 N, TL Parkertown, TL Clarktown, on Lt

SUBDIVISION _____ BLOCK / SECTION _____ LOT _____ LOT AREA _____ SITE CLASS. A5 DESIGN FLOW 360 L.T.A.R. 0.3

Septic Tank: 1000 Gallons; STB 3/2 Date 2/24/05

Pump Tank: _____ Gallons; PT _____ Date _____

Pump Make: _____ Model _____ Serial No. _____

Nitrification Field: No Fields 1 Square Feet 900 Linear Feet 300'

No Lines 3 @ 100' Trench Width 36" Max Trench Bottom Depth 36" Gravel Depth —

☒ New System ☐ Repair System Type: I, II, III, IV, V, VI

System Description: Gravity 25% reduct

Repair System Description: Same

Maintenance Agreement Required: ☐ Yes ☒ No

☐ House/Mod. Home No. Bedrooms 3

☒ Mobile Home No. Bathrooms ____

☐ Business No. Employees ____

☐ Other _____


☐ Slab ☒ Crawl Space ☐ Basement w/plumbing ☐ Basement wo/plumbing

Water Supply: ☒ Individual ☐ Public ☐ Community

Comments:/Conditions:

Not to Scale

INITIAL SITE SKETCH

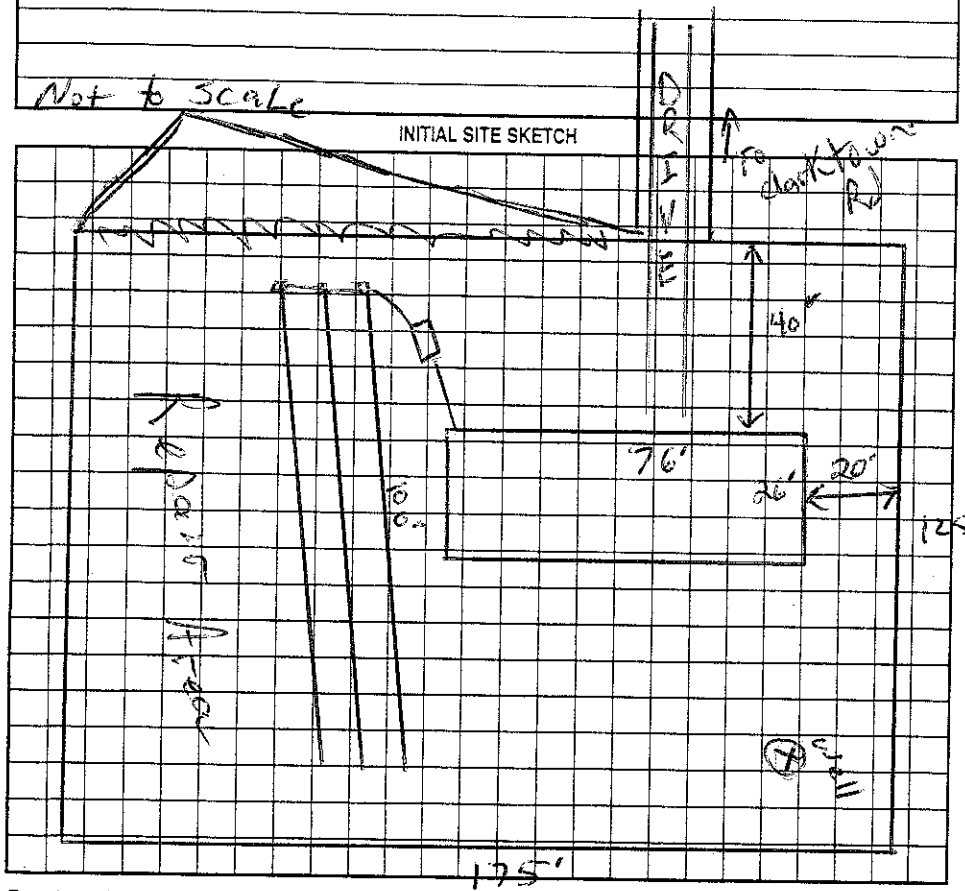

Comments:/Conditions:

AS BUILT SKETCH

Quick 4's Installed

Permit can be suspended or revoked if any false information is supplied toward securing the permit/any unauthorized changes are made to the site/any unauthorized changes are made in the installation of the system. Improvement Permit with plat valid without expiration. Improvement Permit with site plan valid for sixty months. Authorization to Construct is valid for a period equal to that of Improvement Permit – not to exceed sixty months.

Signed: Audrey Hurst date _____ Installed by: Specialty Septic

Improvement Permit by: RS date 2/21/05 Operation Permit by: RS date 4/15/05

Authorization to Construct by: RS date 2/21/05 Existing System Inspection by: _____ date _____

HEALTH DEPT. COPY: WHITE OWNER COPY (FINAL): YELLOW OWNER COPY (INITIAL): PINK