3 ⇔ ACORNELIUS

IREDELL COUNTY HEALTH DEPARTMENT

STATESVILLE 704-878-5305 MOORESVILLE 704-664-5281

IMPROVEMENT PERMIT / AUTHORIZATION TO CONSTRUCT / OPERATION PERMIT / EXISTING SYSTEM INSPECTION

PERMIT# 076398 PIN# 4659 24 1382 DATE 10/14/98

OWNER OR CONTRACTOR Tomika Hart PHONE: Business Home 660-1939

ADDRESS 153 Parkertown Rd. Mooresville, NC. 28115

LOCATION Parkertown Rd, 115-2 NTL Parkertown Rd. ~ 1/8 mile on (R)

SUBDIVISION MARLO CORP BLOCK / SECTION LOT 12 LOT AREA .45 SITE CLASS. PS DESIGN FLOW 360 L.T.A.R. .3

Septic Tank: 1000 Gallons; STB 799 Date 2/26/99
Pump Tank: Gallons; PT Date
Pump Make: Model Serial No.
Nitrification Field: No Fields 1 Square Feet 1200 Linear Feet 400
No Lines 5 Trench Width 36" Max Trench Bottom Depth 36" Gravel Depth 12"

[X] New System [ ] Repair System Type: I, [II], III, IV, V, VI
System Description: GRAV - CONVENTIONAL
Repair System Description: SAME
Maintenance Agreement Required: [ ] Yes [ ] No

[ ] House/Mod. Home No. Bedrooms 3
[X] Mobile Home No. Bathrooms 3
[ ] Business No. Employees
[ ] Other


[ ] Slab [X] Crawl Space [ ] Basement w/plumbing [ ] Basement wo/plumbing

Water Supply: [X] Individual [ ] Public [ ] Community


Comments:/Conditions: Use one Drop Box per drain line

Comments:/Conditions:

INITIAL SITE SKETCH

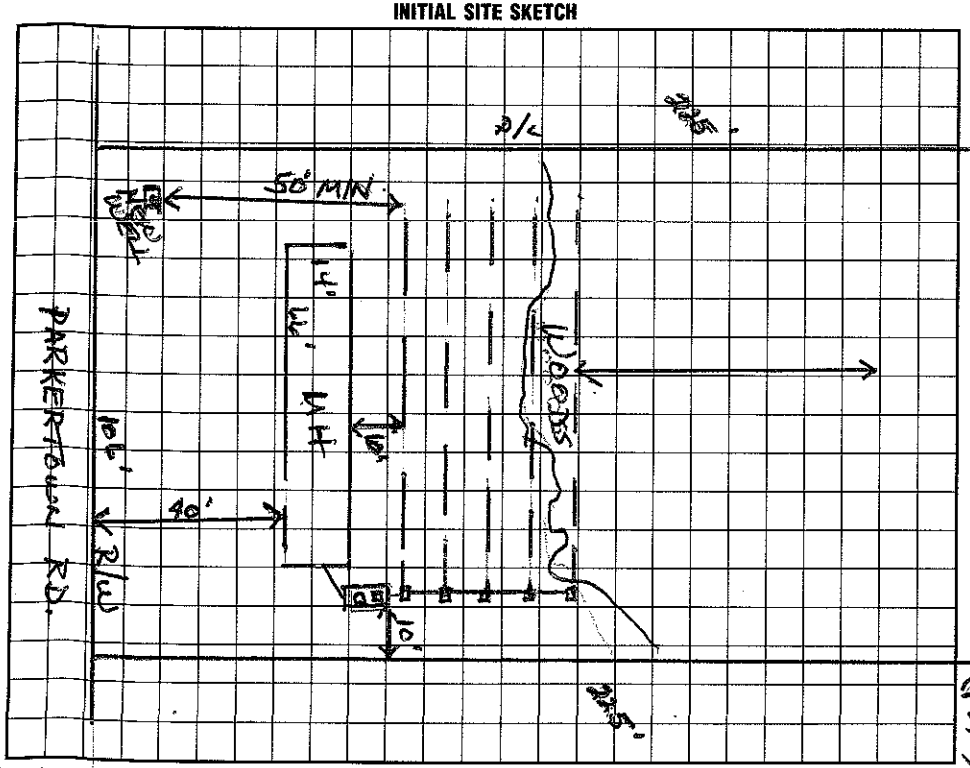

AS BUILT SKETCH

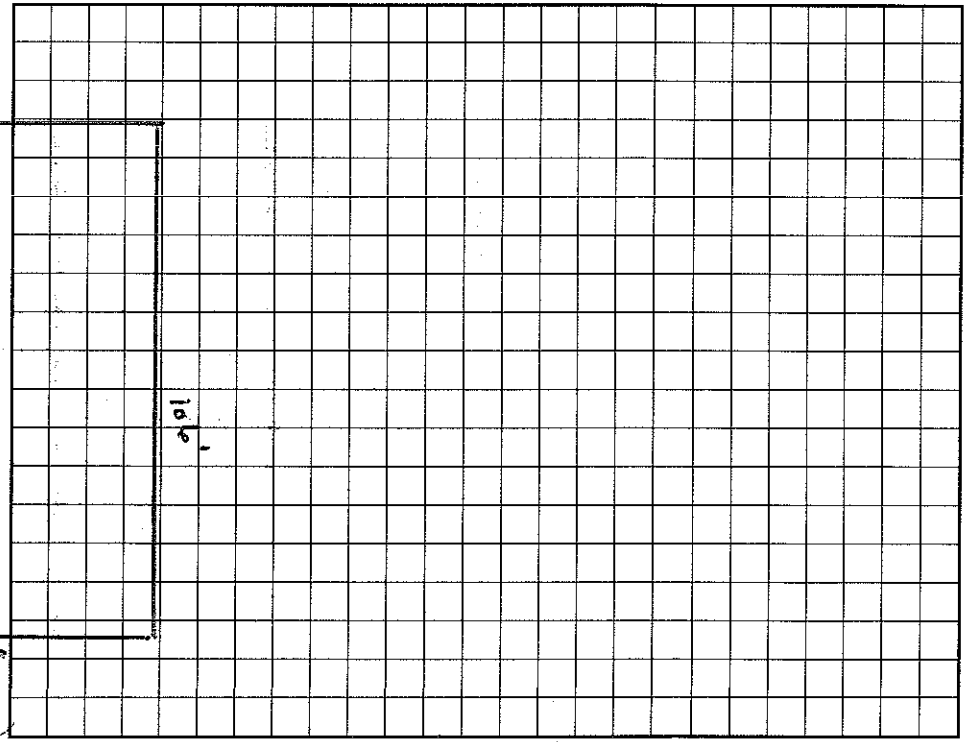

I understand that this permit can be suspended or revoked if any false information is supplied toward securing the permit/any unauthorized changes are made to the site/any unauthorized changes are made in the installation of the system. Improvement Permit with plat valid without expiration. Improvement Permit with site plan valid for sixty months. Authorization to Construct is valid for a period equal to that of Improvement Permit – not to exceed sixty months.

Signed: X Tomika Hart date 3-2-98 Installed by: Cornelius Septic

Improvement Permit by: Wesley Sparks RS. date 10/14/98 Operation Permit by: Jeff Morgan date 5/12/99

Authorization to Construct by: Wesley Sparks RS. date 10/14/98 Existing System Inspection by: date

HEALTH DEPT. COPY: WHITE INSPECTION COPY (FINAL): GREEN OWNER COPY (FINAL): YELLOW INSPECTION COPY (INITIAL): PINK OWNER COPY (INITIAL): GOLD