IREDELL COUNTY HEALTH DEPARTMENT

STATESVILLE 704-878-5305 MOORESVILLE 704-664-5281

after 3:00

IMPROVEMENT PERMIT / AUTHORIZATION TO CONSTRUCT / OPERATION PERMIT / EXISTING SYSTEM INSPECTION

PERMIT# 070975 PIN# 4659246300

OWNER OR CONTRACTOR Pessies Smith PHONE: Business DATE 1/7/97

ADDRESS 126 Parkertown Rd. Mooresville, NC 28115 Home 528-6059

LOCATION 115 N to Parkertown 8th lot on Right beside third house.

SUBDIVISION BLOCK / SECTION LOT LOT AREA Acreage SITE CLASS. PS DESIGN FLOW 240gpd L.T.A.R. .3

Septic Tank: 1000 Gallons; STB 794 Date 10-6-97

Pump Tank: Gallons; PT Date

Pump Make: Model Serial No.

Nitrification Field: No Fields 1 Square Feet 750+ Linear Feet 250+

No Lines 5 at 50'+ Trench Width 36" Max Trench Bottom Depth 22" Gravel Depth 12"

☒ New System ☐ Repair System Type: (II), III, IV, V, VI

System Description: Gravity Conventional

Repair System Description:

Maintenance Agreement Required: ☐ Yes ☒ No

☐ House/Mod. Home ☒ Mobile Home ☐ Business ☐ Other

No. Bedrooms 3 No. Bathrooms 2 No. Employees

☐ Slab ☒ Crawl Space ☐ Basement w/plumbing ☐ Basement wo/plumbing


Water Supply: ☒ Individual ☐ Public ☐ Community

Comments:/Conditions: Keep Septic System at least 10' from Property lines 5' From Home & 50' From well. Well must be "drilled" well. MH can not be greater than 60' From road.


Comments:/Conditions: Lot deeded prior to 1982. Well not installed at time of inspection. MH

INITIAL SITE SKETCH

Scale 1:50

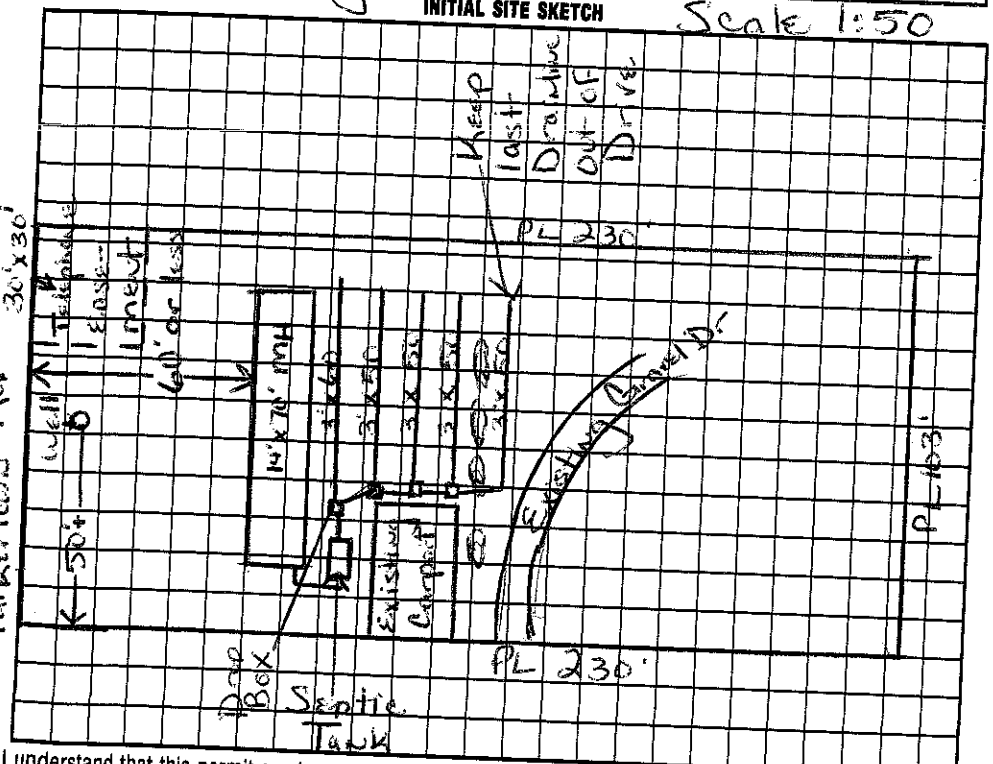

AS BUILT SKETCH

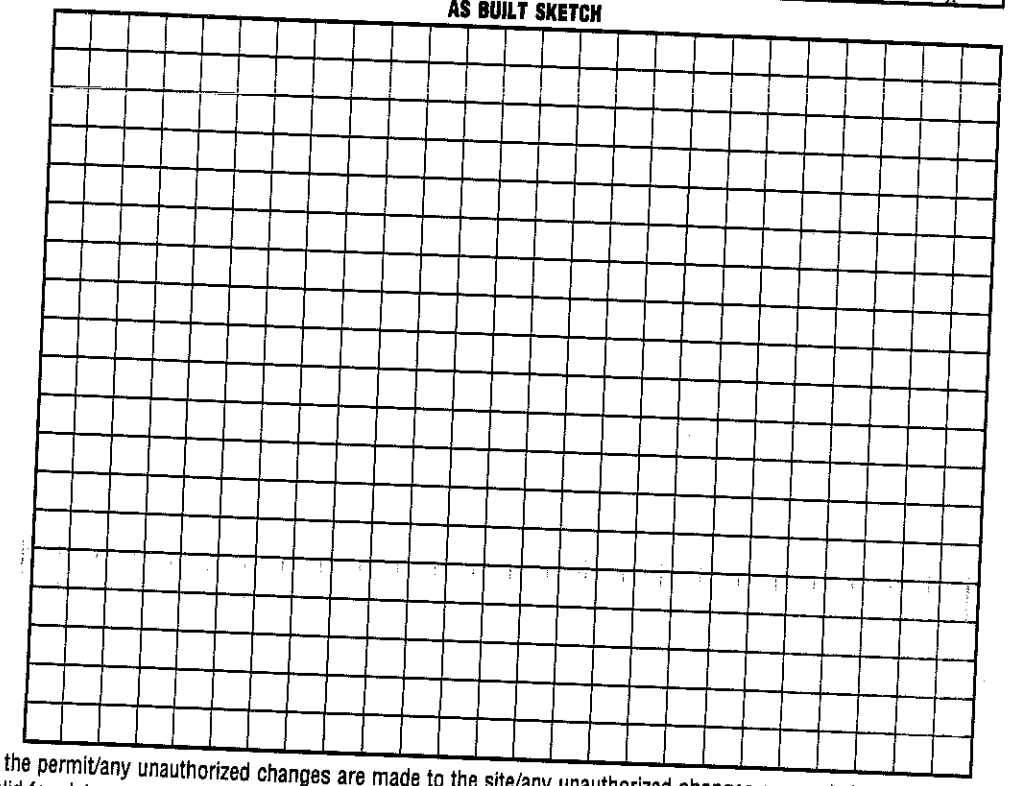

I understand that this permit can be suspended or revoked if any false information is supplied toward securing the permit/any unauthorized changes are made to the site/any unauthorized changes are made in the installation of the system. Improvement Permit with plat valid without expiration. Improvement Permit with site plan valid for sixty months. Authorization to Construct is valid for a period equal to that of Improvement Permit – not to exceed sixty months.

Signed: James O Smith

Improvement Permit by: Maria H. Dotson date 1-8-98

Authorization to Construct by: Maria H. Dotson date 1/7/97

Installed by: LaVon Benton

Operation Permit by: Maria H. Dotson date 1/7/97

Existing System Inspection by: Maria H. Dotson date 1/4/98

HEALTH DEPT. COPY: WHITE INSPECTION COPY (FINAL): GREEN OWNER COPY (FINAL): YELLOW INSPECTION COPY (INITIAL): PINK OWNER COPY (INITIAL): GOLD