As Built

IREDELL COUNTY HEALTH DEPARTMENT

STATESVILLE 704-878-5305 MOORESVILLE 704-664-5281

IMPROVEMENT PERMIT / AUTHORIZATION TO CONSTRUCT / OPERATION PERMIT / EXISTING SYSTEM INSPECTION

PERMIT # 138535 PIN # 4659247708 DATE 12-8-08

OWNER or APPLICANT Iris Westmoreland PHONE: Business 704 664-7000 Home: 704 663-5088

OWNER or APPLICANT ADDRESS 2056 Coddle Creek Hwy Mooresville, NC

LOCATION / DIRECTIONS Hwy 21/115 past Shepherd School on left across from Cemetery (1502 Charlotte Hwy)

SUBDIVISION Marlo Corp BLOCK / SECTION LOT # 3 LOT AREA .53Acre DESIGN FLOW 360 L.T.A.R. .3/.25R

Septic Tank 1000 Gallons: STB 794 Date 10-28-08 ☒ New System ☐ Repair ☐ Expansion System Type I II (III) IV V VI

Pump Tank Gallons: P T Date System Description: Gravity - Panel Blk

Pump Make Model Serial # Repair System Description: Pres. LP - Panel Blk

Nitrification Field No Fields 1 No Lines 4 Linear Feet 200' Maintenance Agreement Required ☐ YES ☒ NO

Trench Width min 24" Max. Trench Bottom Depth 36" Gravel Depth N/A ☒ GRAVITY ☐ PRESSURE


☒ Residence No. Bedrooms 3 ☐ Business No. Persons ☐ Other No. Employees ☐ Slab ☐ Crawl Space ☐ Basement w/plumbing ☒ Basement w/o plumbing

Water Supply: ☒ Private ☐ Public ☐ Community

Comments / Conditions

Comments / Conditions

INITIAL SITE SKETCH

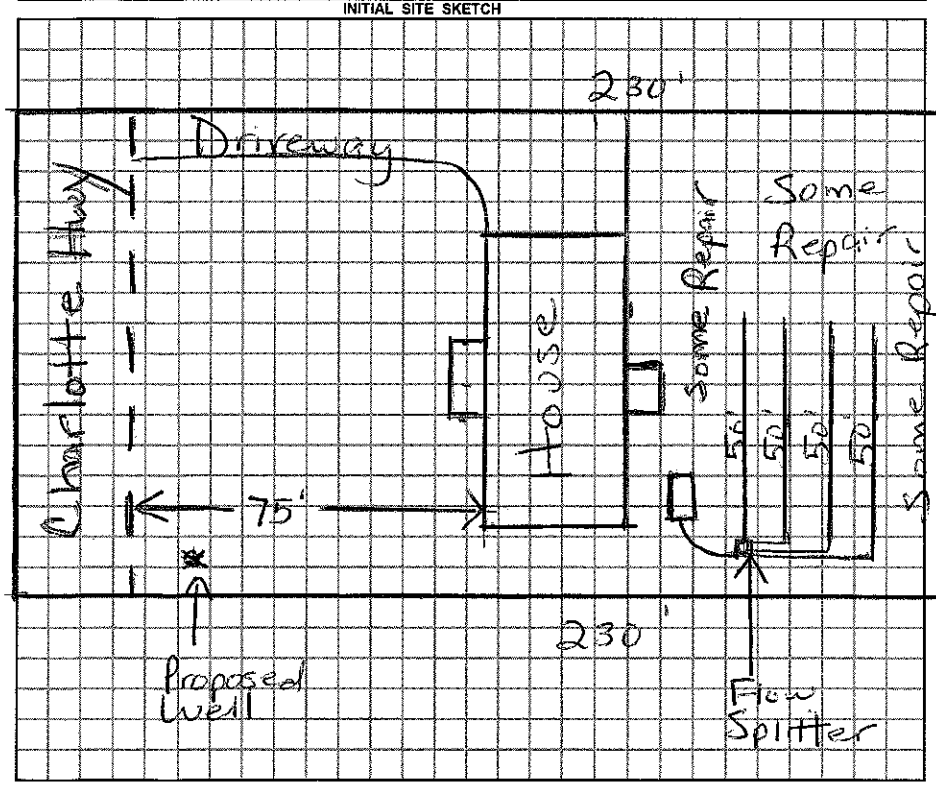

AS BUILT SKETCH

Permit can be suspended or revoked if any false information is supplied toward securing the permit / any unauthorized changes are made to the site / any unauthorized changes are made in the installation of the system.

☐ *IMPROVEMENT PERMIT w / plat valid without expiration.* ☐ *IMPROVEMENT PERMIT w / site plan valid for 60 mos.* ☐ *AUTHORIZATION TO CONSTRUCT valid for period equal to IMPROVEMENT PERMIT-not to exceed 60 mo.*

Owner / Applicant Signature: Date

Improvement Permit by: Marie H. Dotson RS Date 12/8/08

Authorization to Construct by: Marie H. Dotson RS Date 12/8/08

YOU SHOULD CONTACT A LOCATOR SERVICE PRIOR TO ANY EXCAVATION.

Installed by:

Operation Permit by: Date:

Existing System Inspected by: Marie H. Dotson RS Date: 12/8/08

WHITE COPY Environmental Health YELLOW COPY (Final) Owner / Applicant PINK COPY (Initial) Owner / Applicant