# IREDELL COUNTY HEALTH DEPARTMENT

STATESVILLE 704-878-5305 MOORESVILLE 704-664-5281

## IMPROVEMENT PERMIT / AUTHORIZATION TO CONSTRUCT / OPERATION PERMIT / EXISTING SYSTEM INSPECTION

PERMIT# 138535 PIN# 4659247708 DATE 10-23-06

OWNER OR APPLICANT Milton Turner Iris Westmoreland PHONE: Business 704-278-7559 Home

ADDRESS 151 Green Acres Dr Mooresville 28115

LOCATION 21/15 N past Shephard School on left across from cemetary between 1496 & 1506 Charlotte Hwy

SUBDIVISION BLOCK / SECTION LOT 3 LOT AREA 1.53 Ac SITE CLASS. PS DESIGN FLOW 360gpd L.T.A.R. .3 gpd/ft² .25 repair

Septic Tank: 1000 Gallons: STB 794 Date 10-28-08
Pump Tank: Gallons: PT Date
Pump Make: Model Serial No.
Nitrification Field: No Fields 1 Square Feet 1200 Linear Feet 200
No Lines 5@40' Trench Width 24" Max Trench Bottom Depth 36" Gravel Depth NA

☒ New System ☐ Repair ☐ Expansion System Type: I II (III) IV V VI
System Description: panel block, gravity
Repair System Description: LP panel
Maintenance Agreement Required: ☐ Yes ☒ No

☐ House/Mod. Home ☒ Mobile Home ☐ Business ☐ Other
No. Bedrooms 3 No. Persons 6 No. Employees


Water Supply: ☒ Individual ☐ Public ☐ Community

☐ Gravity ☐ Pressure ☐ Slab ☒ Crawl Space ☐ Basement w/plumbing ☐ Basement wo/plumbing

Comments/Conditions: ① Surface Diversion Ditch to catch water from culvert on neighbors property to run next to property line diverting water away from septic field ② Flow splitter such as Zoeller


INITIAL SITE SKETCH

1" = 40'

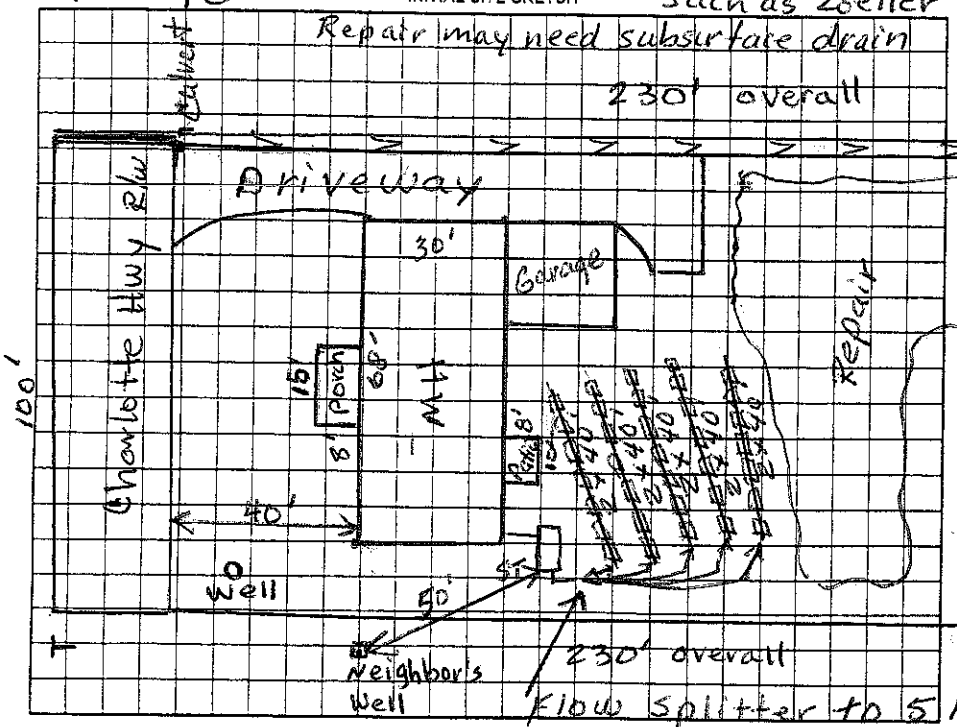


Comments/Conditions: Note: Do not Cut within 25ft of drainfield for basement otherwise may need to pump. (Actual bedrooms on Floor plan = 2)

AS BUILT SKETCH

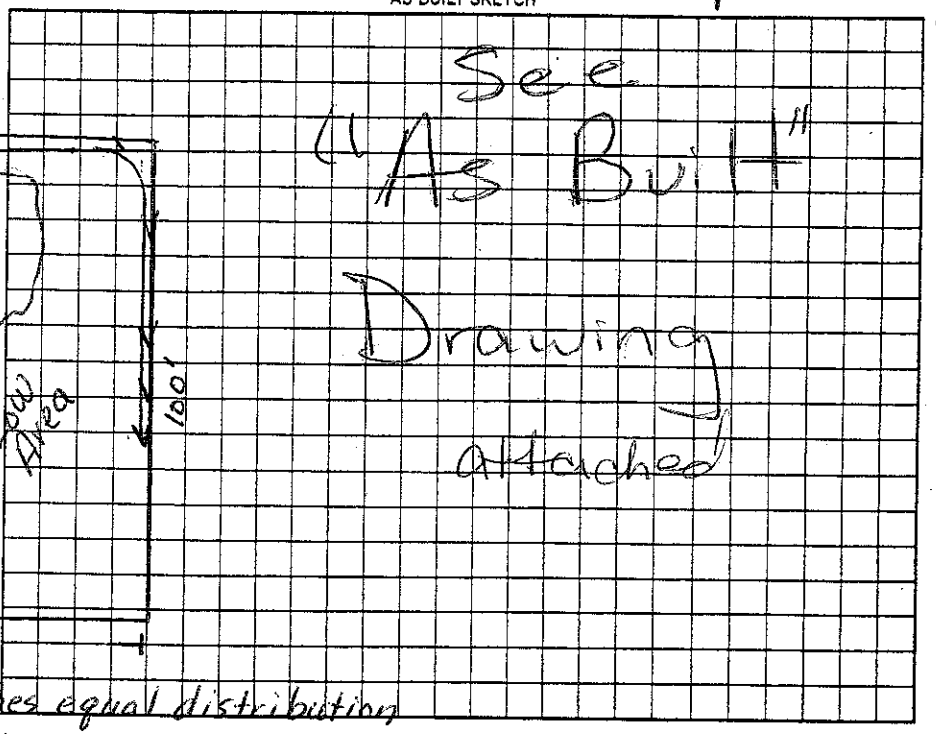


Permit can be suspended or revoked if any false information is supplied toward securing the permit/any unauthorized changes are made to the site/any unauthorized changes are made in the installation of the system. Improvement Permit with plat valid without expiration: ☐ Improvement Permit with site plan valid for sixty months ☒ Authorization to Construct is valid for a period equal to that of Improvement Permit – not to exceed sixty months.

Signed: date 1/30/06 Installed by: Larry Beam RS

Improvement Permit by: Judy Melville RS date 10-27-06 Operation Permit by: Marian H. Dolan RS date 12/5/08

Authorization to Construct by: Marian H. Dolan RS date 4/10/08 Existing System Inspection by: date

HEALTH DEPT. COPY: WHITE OWNER COPY (FINAL): YELLOW OWNER COPY (INITIAL): PINK