IREDELL COUNTY HEALTH DEPARTMENT

Authorization to construct 4659-24-8561

STATESVILLE 704-878-5305 MOORESVILLE 704-664-5281

IMPROVEMENT PERMIT / ~~CERTIFICATE OF COMPLETION~~ / OPERATION PERMIT / EXISTING SYSTEM INSPECTION

PROPERTY DESCRIPTION NO. 22142 DATE 10/9/95 TAX MAP NO. 4E 2A 6 Watershed: ☐ Yes ☒ No

OWNER OR CONTRACTOR Hugh C Cowan PHONE: Business _____ Home 528-6050

ADDRESS 138 Parkertown Rd. Mooresville, NC 28115

LOCATION on (R) just past Parkertown Rd.

SUBDIVISION Monte Colby BLOCK / SECTION _____ LOT 6 LOT AREA .67 SITE CLASS. PS DESIGN FLOW 360 L.T.A.R. .35

Septic Tank: 1000 Gallons; STB 1612 Date 9/9/95
Pump Tank: _____ Gallons; PT _____ Date _____
Pump Make: _____ Model 1635 Serial No. _____
Nitrification Field: No Fields 1 Square Feet ~~1200~~ Linear Feet * 345
No Lines 3 Trench Width 36" Max Trench Bottom Depth 36" Gravel Depth N/A

☒ New System ☐ Repair System Type: I, II, (III), IV, V, VI
System Description: Gravity Low Pressure
Repair System Description: _____
Maintenance Agreement Required: ☐ Yes ☒ No


☒ House/Mod. Home No. Bedrooms 3
☐ Mobile Home No. Bathrooms 1
☐ Business No. Employees _____
☐ Other _____
☐ Slab ☒ Crawl Space ☐ Basement w/plumbing ☐ Basement wo/plumbing

Water Supply:
☒ Individual
☐ Community
☐ Public
Cowans


Comments: * 25% reduction for shallow trench use

Comments:

INITIAL SITE SKETCH

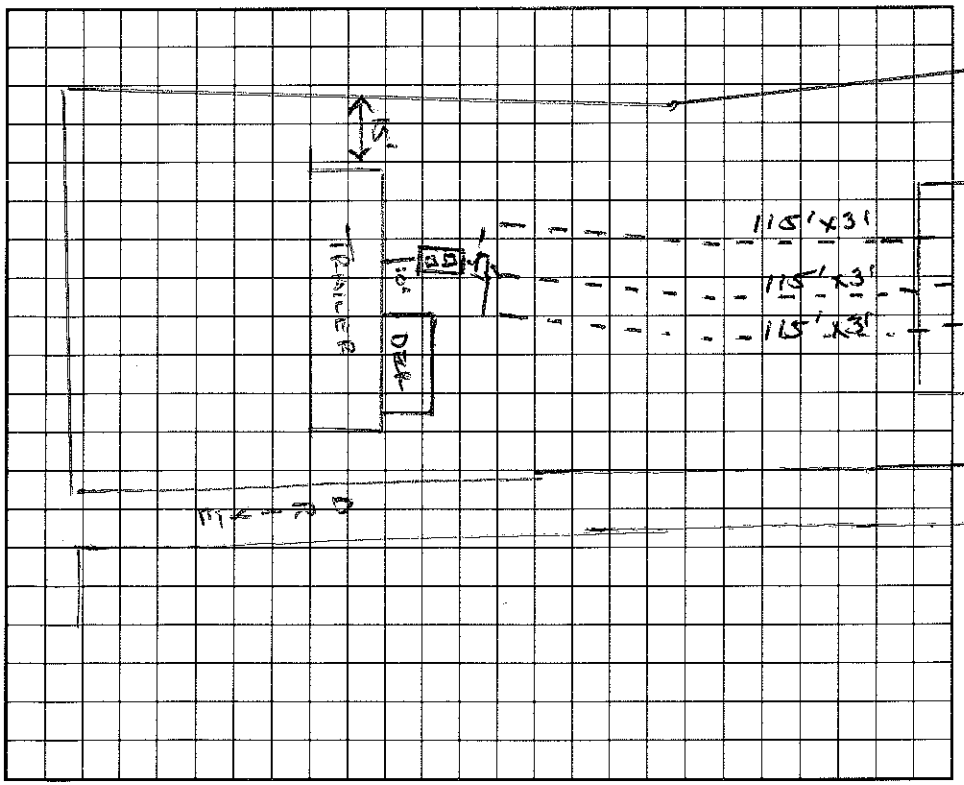

AS BUILT SKETCH

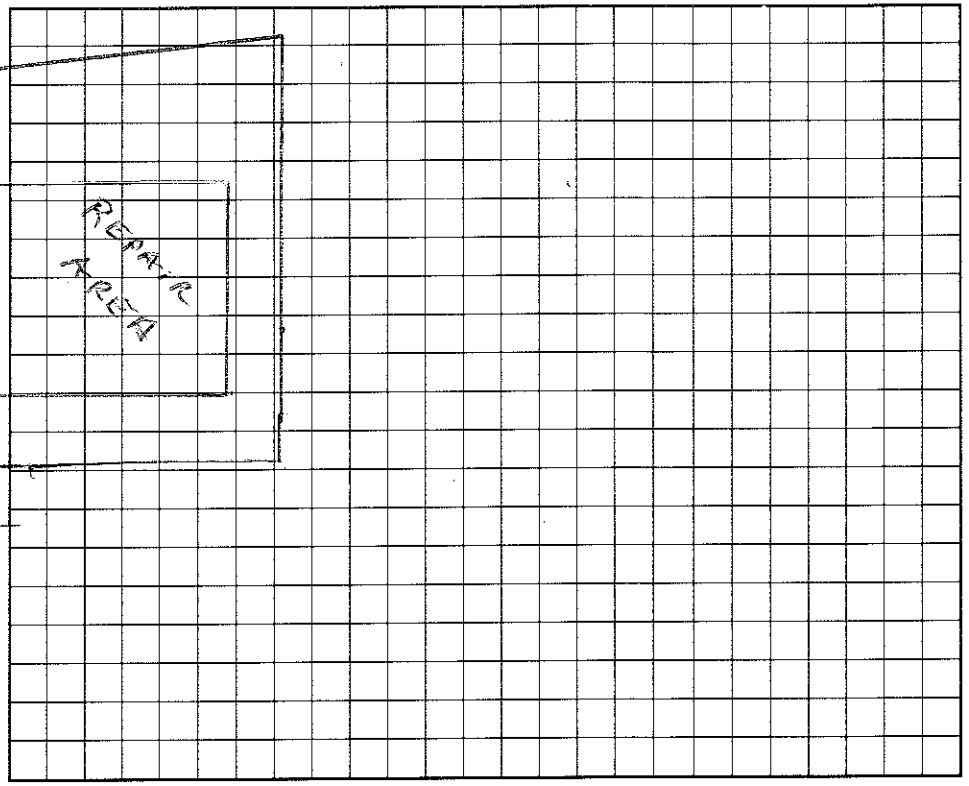

I understand that this permit can be suspended or revoked if any false information is supplied toward securing the permit/any unauthorized changes are made to the site/any unauthorized changes are made in the installation of the system.

Signed: Hugh C Cowan

Improvement Permit by: Wesley Sparks R.S. date 10/9/95

~~Authorization to Construct~~ / Existing System Inspection by: Wesley Sparks RS date 10/9/95

Installed by: Forest Shuford.

Certificate of Completion by: Wesley Sparks R.S. date 11/28/95

Operation Permit by: Wesley Sparks R.S. date 11/28/95

HEALTH DEPT. COPY: WHITE INSPECTION COPY (FINAL): GREEN OWNER COPY (FINAL): YELLOW INSPECTION COPY (INITIAL): PINK OWNER COPY (INITIAL): GOLD