IREDELL COUNTY HEALTH DEPARTMENT

Statesville Office (704) 878-5305 Mooresville Office (704) 660-3625 PERMIT # 214334

IMPROVEMENT PERMIT / AUTHORIZATION TO CONSTRUCT / OPERATION PERMIT / EXISTING SYSTEM

PIN # 4659250328

APPLICANT: SOIL & FORESTRY SERVICES APPLICANT ADDRESS: PO BOX 832 MOORESVILLE 28115

SITE ADDRESS: 145 AUTUMN GROVE LN MOORESVILLE NC 28115 PHONE: ALT. PHONE: 704-622-5152

SITE DIRECTIONS: 21(N) - TL CLEAR SPRINGS RD - TL AUTUMN GROVE - ON LT

SUBDIVISION: AUTUMN GROVE SECTION: LOT # 61 LOT AREA: .63 AC DESIGN FLOW: 480 L.T.A.R.: .3

Septic Tank NEW 1000 (gal) STB Plastic Date Same SI
Pump Tank EXISTING (gal) PT Date
Pump Make Model Serial #
Nitrification Fields 1 # Lines 5 Linear Ft: 400
Trench Width 36" Max. Trench Bottom Depth EXISTING Gravel Depth N/A

☑ New System ☐ Repair ☐ Expansion System Type: I II (III) IV V VI
System Description: PUMP 25% REDUCTION
Repair System Description: 4 BEDS
Maintenance Agreement Required: ☐ YES ☑ NO
☐ GRAVITY ☑ PRESSURE

☑ Residence No. Bedrooms 4
☐ Business No. Persons 8
☐ Other No. Employees
☐ Slab ☑ Crawl Space
☐ Basement w/plumbing ☐ Basement w/o plumbing

Water Supply: ☑ Private ☐ Public ☐ Community

Comments / Conditions:

* NEW TANK LOCATION ONLY *
10/26/15 Checked New ST & Checked Pump elect. & alarm

INITIAL SITE SKETCH

SEE SOIL & FORESTRY SERVICES OF THE CAROLINAS, PA DESIGN

AS BUILT SKETCH

Permit can be suspended or revoked if any false information is supplied toward securing the permit / any unauthorized changes are made to the site / any unauthorized changes are made in the installation of the system. CONTACT A LOCATOR SERVICE PRIOR TO ANY EXCAVATION

☐ IMPROVEMENT PERMIT with plat valid without expiration. ☐ IMPROVEMENT PERMIT with site plan valid for 60 mos. ☑ AUTHORIZATION TO CONSTRUCT valid for period equal to IMPROVEMENT PERMIT--not to exceed 60 mo.


Owner / Applicant Signature: Date: 10-26-15 Installed by: Sid Hopkins

IMPROVEMENT PERMIT by: Date: 10/22/15 OPERATION PERMIT by: Marcus Dotson RS Date: 10/26/15

AUTHORIZATION TO CONSTRUCT by: Date: 10/22/15 Existing System Inspected by: Date:

Health Dept. Copy - WHITE Applicant (Final Approval) - YELLOW Applicant (Conditional Approval) - PINK

I, WILLIAM T. POWELL, JR., CERTIFY THAT THIS PLAT WAS DRAWN UNDER MY SUPERVISION FROM AN ACTUAL SURVEY MADE UNDER MY SUPERVISION (DEED DESCRIPTION RECORDED IN BOOK _____ PAGE ____, ETC)(OTHER); THAT BOUNDARIES NOT SURVEYED ARE CLEARLY INDICATED AS DRAWN FROM INFORMATION FOUND IN BOOK 53, PAGE 53 ; THAT THE RATIO OF PRECISION AS CALCULATED IS 1:7,500+ ; THAT THIS PLAT WAS PREPARED IN ACCORDANCE WITH G.S.47-30 AS AMENDED. WITNESS MY ORIGINAL SIGNATURE, REGISTRATION NUMBER AND SEAL THIS 21ST DAY OF OCTOBER, A.D., 2014.

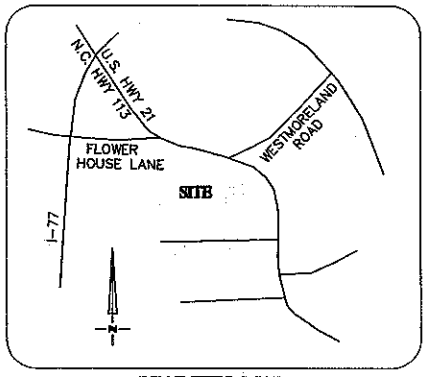


VICINITY MAP
Not To Scale

BY_____ (PLS)
WILLIAM T. POWELL, JR. NCPLS L-3981

LEGEND

E.I.P.	EXISTING IRON PIN
E.C.M.	EXISTING CONCRETE MONUMENT
S.I.P.	SET IRON PIN
P.D.E.	PUBLIC DRAINAGE EASEMENT
P.U.E.	PUBLIC UTILITY EASEMENT
S.S.E.	SANITARY SEWER EASEMENT
F.P.E.	FLOOD PROTECTION ELEVATION
CLOSURE	EXCEEDS 1 INCH in 10,000'
———	PROPERTY LINE
- - - - -	ADJOINER PROPERTY LINE BY DEED OR PLAT

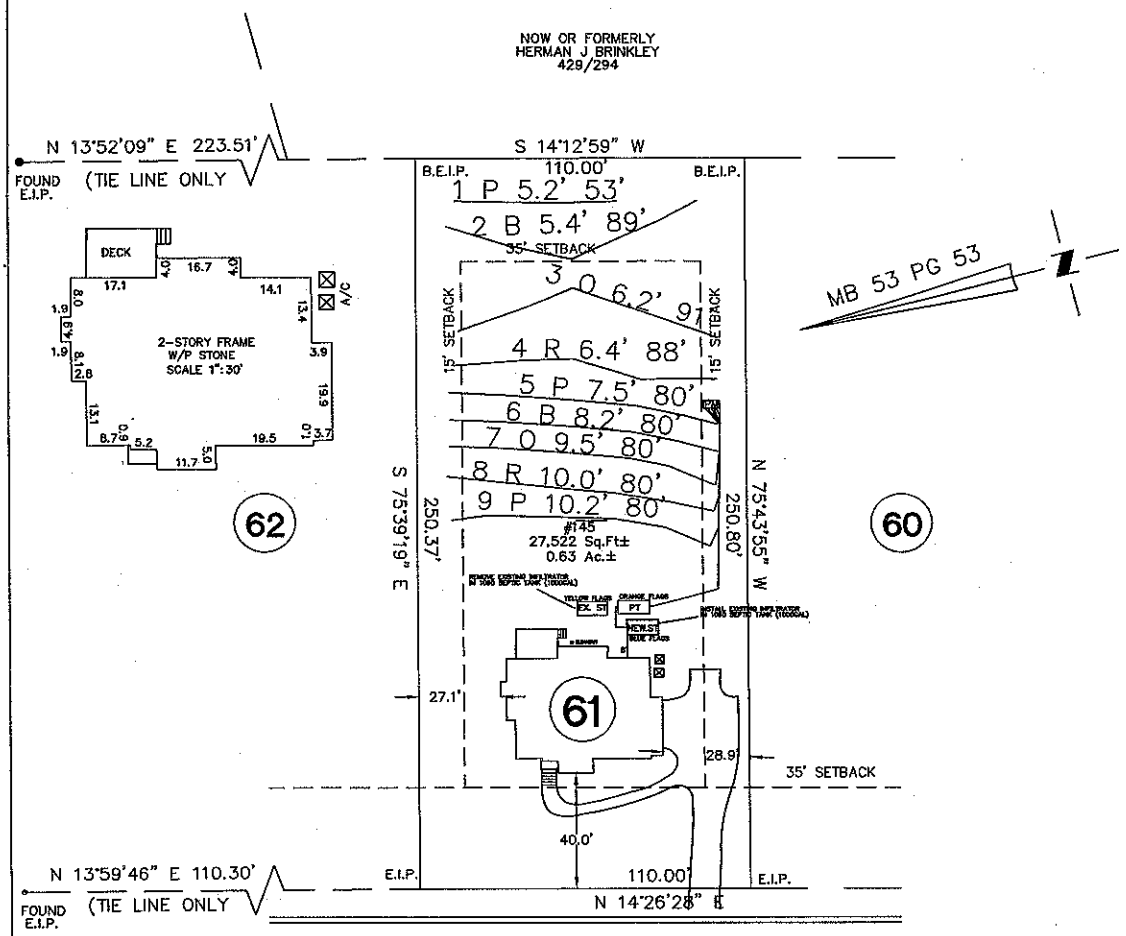

THIS PROPERTY MAY BE SUBJECT TO ANY AND ALL APPLICABLE DEED RESTRICTIONS, EASEMENTS, RIGHT-OF-WAY, UTILITIES AND RESTRICTIVE COVENANTS WHICH MAY BE OF RECORD OR IMPLIED

50 0 50
SCALE: 1" = 50'

EASTOVER
LAND SURVEYING COMPANY, P.A.
LAND SURVEYORS - PLANNERS
600 TOWNE CENTRE BOULEVARD, SUITE #309
PINEVILLE, NORTH CAROLINA 28134
PHONE (704) 927-8080
FAX (704) 889-0105

PHYSICAL SURVEY

FOR

LOT 61, AUTUMN GROVE SUBDIVISION, PHASE 2
Barringer Township, Iredell County, North Carolina

PROPERTY OF: ESSEX HOMES

MAP BOOK 53 PAGE 53 DEED REFERENCE _____

DRAWN BY: BUI | DATE: OCTOBER 22, 2014