IREDELL COUNTY HEALTH DEPARTMENT

STATESVILLE 704-878-5305 MOORESVILLE 704-664-5281

IMPROVEMENT PERMIT / AUTHORIZATION TO CONSTRUCT / OPERATION PERMIT / EXISTING SYSTEM INSPECTION

PERMIT# 143878 PIN# 4659 15 4617 4659-26-0440 DATE 8/21/07

OWNER OR APPLICANT E + J Development Co. / C+B CONST. PHONE: Business 704-201-6465 Home

ADDRESS PO Box 1065 Huntersville NC. 28070

LOCATION 115-21 N TL on new road before Wynward Point, 2nd on R Clear Springs

SUBDIVISION Autumn Grove BLOCK / SECTION 1 LOT 2 LOT AREA .55 SITE CLASS. PS DESIGN FLOW 480 L.T.A.R. .275

Septic Tank: 1000 Gallons; STB 794 Date 2/24/08

Pump Tank: Gallons; PT Date

Pump Make: Model Serial No.

Nitrification Field: No Fields 1 Square Feet Linear Feet 290

No Lines 8@37' Trench Width 3' Max Trench Bottom Depth 3' Gravel Depth No

[X] New System [ ] Repair [ ] Expansion System Type: I II (III) IV V VI

System Description: FLOWDIVIDER-2-DIST BOXES

Repair System Description: Pressdosed PPBPS

Maintenance Agreement Required: [ ] Yes [X] No

[X] House/Mod. Home [ ] Mobile Home [ ] Business [ ] Other

No. Bedrooms 4 No. Persons No. Employees


Water Supply: [X] Individual [ ] Public [ ] Community

[X] Gravity [ ] Pressure [ ] Slab [X] Crawl Space [ ] Basement w/plumbing [ ] Basement wo/plumbing


Comments:/Conditions: System designed with FLOW DIVIDER TO 2 DIST. BOXES W/ SPEED LEVELERS. LINE LENGTHS OVER 50' WILL REQUIRE PRESSURE DISTRIBUTION SITE PLAN MUST BE ON SITE DURING INSTALLATION.

Comments:/Conditions:

INITIAL SITE SKETCH

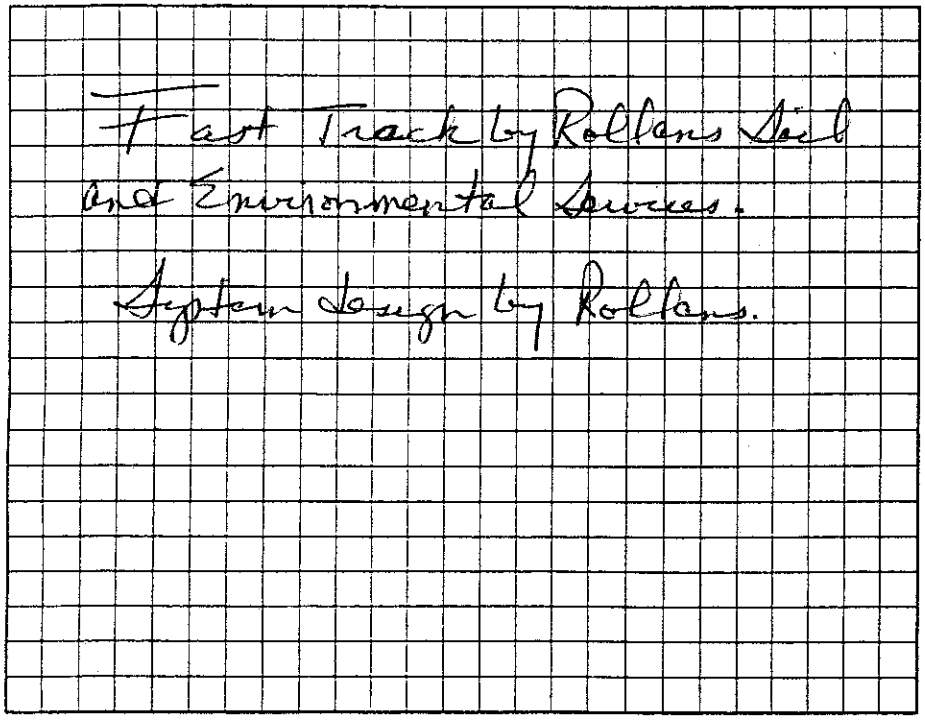

AS BUILT SKETCH

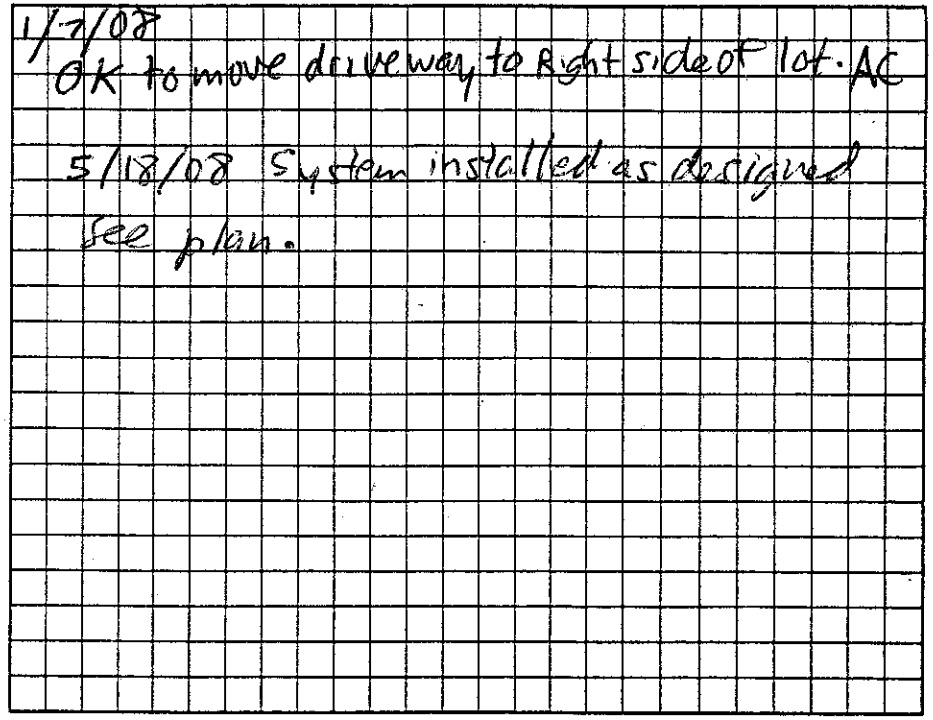

Permit can be suspended or revoked if any false information is supplied toward securing the permit/any unauthorized changes are made to the site/any unauthorized changes are made in the installation of the system. Improvement Permit with plat valid without expiration [ ] Improvement Permit with site plan valid for sixty months [ ] Authorization to Construct is valid for a period equal to that of Improvement Permit – not to exceed sixty months.

Signed: [signature] date 9-24-07 Installed by: A-1 Dockhoe

Improvement Permit by: Wesley Sparks R.S. date 8/21/07 Operation Permit by: Anthony Coker Jr. date 5/18/08

Authorization to Construct by: Wesley Sparks RS date 12/6/07 Existing System Inspection by: date

HEALTH DEPT. COPY: WHITE OWNER COPY (FINAL): YELLOW OWNER COPY (INITIAL): PINK