...TH DEPARTMENT Const. Auth. STATESVILLE 704-878-5305 MOORESVILLE 704-664-5281

4659260610 4:00

...RMIT / ~~CERTIFICATE OF COMPLETION~~ / OPERATION PERMIT / EXISTING SYSTEM INSPECTION

...PTION NO. 25008 DATE Aug 15, '97 TAX MAP NO. part of 4E812

OWNER OR CONTRACTOR Pruitt Dev. Co. PHONE: Business _____ Home _____ Watershed: ☑ Yes ☐ No

ADDRESS 142 Stutts Rd. Mooresville LOCATION US 21 N. TL Sailwinds TL Key West Ln. at end

SUBDIVISION Windward Pt BLOCK / SECTION _____ LOT 80 LOT AREA .86ac SITE CLASS PS DESIGN FLOW 360 gpd L.T.A.R. .3

Septic Tank: 1600 Gallons; STB 825 Date 6/26/97

Pump Tank: _____ Gallons; PT _____ Date _____

Pump Make: _____ Model _____ Serial No. _____

Nitrification Field: No Fields 1 Square Feet 900 Linear Feet 300

No Lines 3@100' Trench Width 36" Max Trench Bottom Depth 24"

☐ New System ☐ Repair System Type: I, II, (III), IV, V, VI

System Description: Gravity chambered/similar type

Repair System Description: SAME

Maintenance Agreement Required: ☐ Yes ☑ No

Gravel Depth NA

☐ House/Mod. Home ☑ Mobile Home DW ☐ Business ☐ Other

No. Bedrooms 3 No. Bathrooms 2 No. Employees _____


☐ Slab ☑ Crawl Space ☐ Basement w/plumbing ☐ Basement wo/plumbing

Water Supply: ☑ Individual ☐ Community ☐ Public

Comments: * ONE INSPECTION part per LATERAL

Comments:

1" = 50' **INITIAL SITE SKETCH**

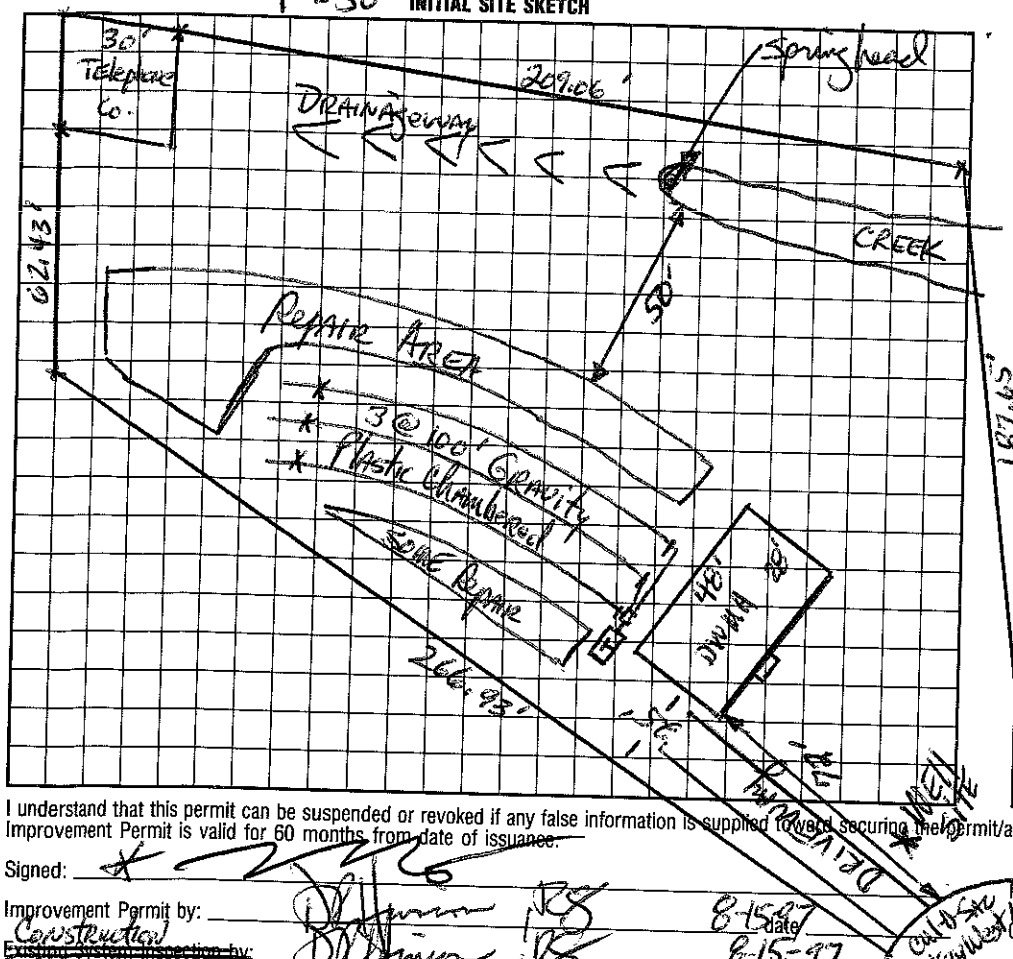

AS BUILT SKETCH

SAME AS SKETCH

I understand that this permit can be suspended or revoked if any false information is supplied toward securing the permit/any unauthorized changes are made to the site/any unauthorized changes are made in the installation of the system. Improvement Permit is valid for 60 months from date of issuance.

Signed: X

Improvement Permit by: _____ date 8-15-97

Construction/~~Existing System~~ Inspection by: _____ date 8-15-97

Author: Initial

Installed by: C & M ENTERPRISES

Certificate of Completion by: _____ date _____

Operation Permit by: _____ date 9/3/97

HEALTH DEPT. COPY: WHITE INSPECTION COPY (FINAL): GREEN OWNER COPY (FINAL): YELLOW INSPECTION COPY (INITIAL): PINK OWNER COPY (INITIAL): GOLD