IREDELL COUNTY HEALTH DEPARTMENT

AUTHORIZATION TO CONSTRUCT

STATESVILLE 704-878-5305 MOORESVILLE 704-664-5281

IMPROVEMENT PERMIT / ~~CERTIFICATE OF COMPLETION~~ / OPERATION PERMIT / EXISTING SYSTEM INSPECTION

PROPERTY DESCRIPTION NO. 25010 DATE 11/19/97 TAX MAP NO. 4E A 12 4659 26 0800 Watershed: ☑ Yes ☐ No

OWNER OR CONTRACTOR PRUITT DEVELOPMENT CO. PHONE: Business _____ Home 875-8001

ADDRESS 290 LAKEVIEW DR. MOORESVILLE NC 28115

LOCATION 21N - TL SAILWINDS - TL KEYWEST LN 7TH ON LT

SUBDIVISION WINDWARD PT BLOCK / SECTION _____ LOT 52 LOT AREA 21780 SITE CLASS. PS DESIGN FLOW 360 L.T.A.R. .3

Septic Tank: 1000 Gallons; STB 921 Date 11/17/97
Pump Tank: _____ Gallons; PT _____ Date _____
Pump Make: _____ Model _____ Serial No. _____
Nitrification Field: No Fields 1 Square Feet 900 Linear Feet 300
No Lines 4 @ 75' Trench Width 36" Max Trench Bottom Depth 36" Gravel Depth N/A

☑ New System ☐ Repair System Type: I, II, III, IV, V, VI
System Description: GRAVITY CHAMBERED ~RIBS
Repair System Description: GRAVITY PANEL
Maintenance Agreement Required: ☐ Yes ☑ No


☑ House/Mod. Home No. Bedrooms 3
☐ Mobile Home No. Bathrooms 2
☐ Business No. Employees ____
☐ Other _____
☐ Slab ☑ Crawl Space ☐ Basement w/plumbing ☐ Basement wo/plumbing

Water Supply:
☑ Individual
☐ Community
☐ Public


Comments:
DRIVE CAN BE LOCATED ON OTHER SIDE OF LOT AND TANK LOCATIONS WOULD CHANGE.

Comments:
Installed as shown by Ruth Const.
Ne well on site

INITIAL SITE SKETCH

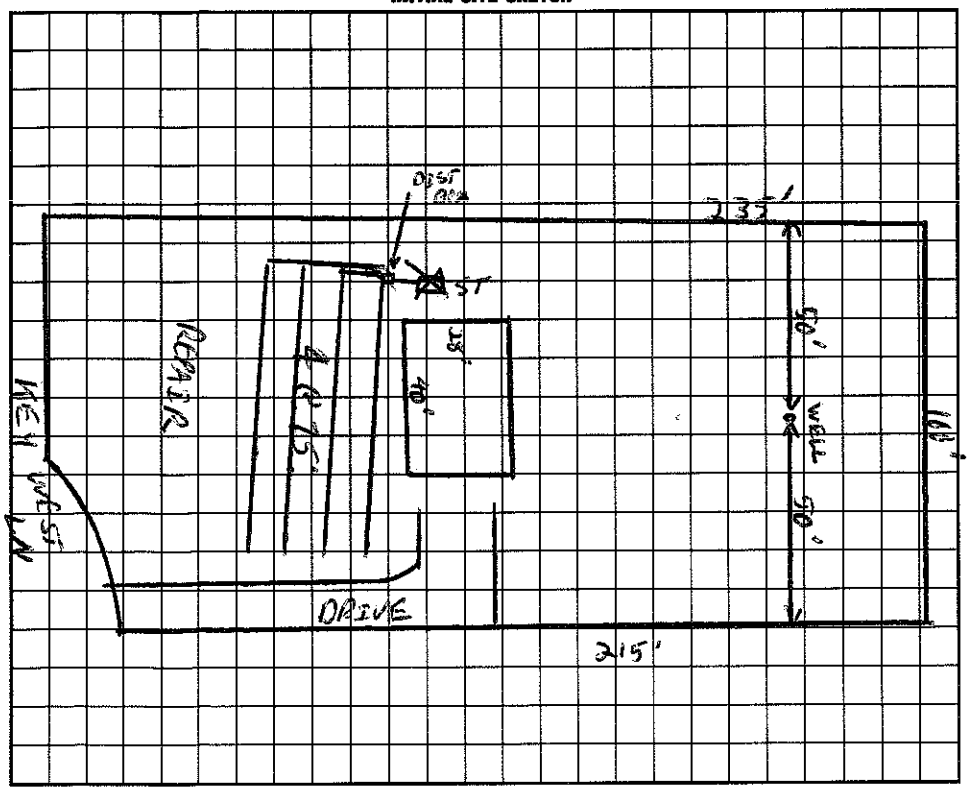

AS BUILT SKETCH

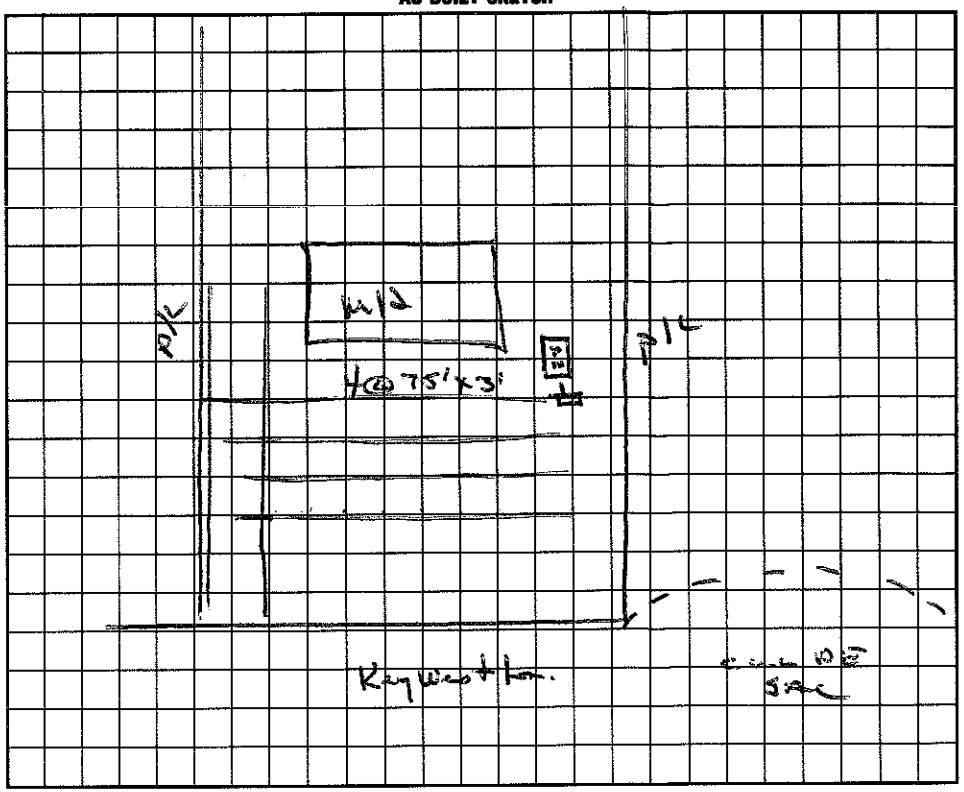

I understand that this permit can be suspended or revoked if any false information is supplied toward securing the permit/any unauthorized changes are made to the site/any unauthorized changes are made in the installation of the system. Improvement Permit is valid for 60 months from date of issuance.

Signed: _____

Improvement Permit by: _____ RS date 11/19/97
~~Existing System Inspection by:~~ AUTHORIZATION _____ RS date 11/19/97

Installed by: Ruth Const.
Certificate of Completion by: Wesley Sparks RS date 11/21/97
Operation Permit by: Wesley Sparks RS date 11/21/97

TO CONSTRUCT HEALTH DEPT. COPY: WHITE INSPECTION COPY (FINAL): GREEN OWNER COPY (FINAL): YELLOW INSPECTION COPY (INITIAL): PINK OWNER COPY (INITIAL): GOLD