4659277215

IREDELL COUNTY HEALTH DEPARTMENT

Statesville Phone TR 3-7271 Mooresville Phone NO 3-1271

PERMIT TO INSTALL SEPTIC TANK

Permit NO. _____ Permit Date 3 Aug 1967

Owner Mr. Shinn / James Hewitt Mairs Address Mooresville

Installed By Ray Nesbitt Address Mooresville


Location of Property Above Blue Door Cemetery

Tank		Capacity		Length of Lines		Fixtures	
Block	( )	1000	( )	225'	(✓)	No. of Baths	( )
Precast	(✓)	1250	( )	250'	( )	Dishwasher	( )
		1500	( )	Other _____		Garbage Grdr.	( )
		Other _____				Other _____	

NOTIFY HEALTH DEPARTMENT AT LEAST EIGHT HOURS BEFORE TANK IS TO BE INSPECTED.

Final Inspection 3 Aug 1967 Approved (✓) Disapproved ( )

Remarks _____

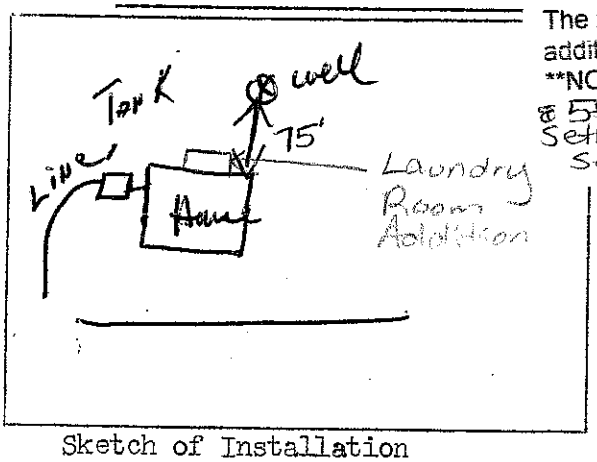

Sketch of Installation

The proposed / existing Laundry Room Addition/Renovation addition does not appear to impact the existing septic system.

**NOTE: Must keep any Building at least 25 from well & 5ft Setback to Septic

Maria Watson R.S.

Date: 9/28/2012

iCHD-Environmental Health Division

Ray Scoggins

Sanitarian