IREDELL COUNTY HEALTH DEPARTMENT

STATESVILLE 704-878-5305 MOORESVILLE 704-664-5281

IMPROVEMENT PERMIT / AUTHORIZATION TO CONSTRUCT / OPERATION PERMIT / EXISTING SYSTEM INSPECTION

PERMIT# 076385 PIN# 4659278434

OWNER OR CONTRACTOR Vickie Beck DATE 9/28/98

ADDRESS 533 Pine Ridge Rd Mocksville NC 27028 PHONE: Business (704) 539-5346 Home (704) 284-4970

LOCATION US 21/Hwy 115 N TR Westmoreland Behind 2nd House on left

SUBDIVISION R.V. Miller BLOCK / SECTION ____ LOT 18 LOT AREA .741 Acre SITE CLASS. PS DESIGN FLOW 360gpd L.T.A.R. .3

Septic Tank: 1000' Gallons; STB 760 Date 8/17/98

Pump Tank: ____ Gallons; PT ____ Date ____

Pump Make: ____ Model ____ Serial No. ____

Nitrification Field: No Fields 1 Square Feet 1200' Linear Feet 345

No Lines ~~4 5 6~~ 7 Trench Width 36" Max Trench Bottom Depth 36"

☒ New System ☐ Repair System Type: I, (II), III, IV, V, VI

System Description: Gravity Conventional

Repair System Description: Pump/Gravity Modified

Maintenance Agreement Required: ☐ Yes ☒ No

Gravel Depth 12" ☐ Slab ☒ Crawl Space ☐ Basement w/plumbing ☐ Basement wo/plumbing

☒ House/Mod. Home No. Bedrooms 3

☐ Mobile Home No. Bathrooms 2

☐ Business No. Employees ____


☐ Other ____

Water Supply: ☒ Individual Shared ☐ Public ☐ Community

Comments:/Conditions: Keep Septic System at least 10' from PL & 5' from House

Comments:/Conditions: Checked Tanks 1st 2 lines 10/7/98 MZE

INITIAL SITE SKETCH Scale 1:60

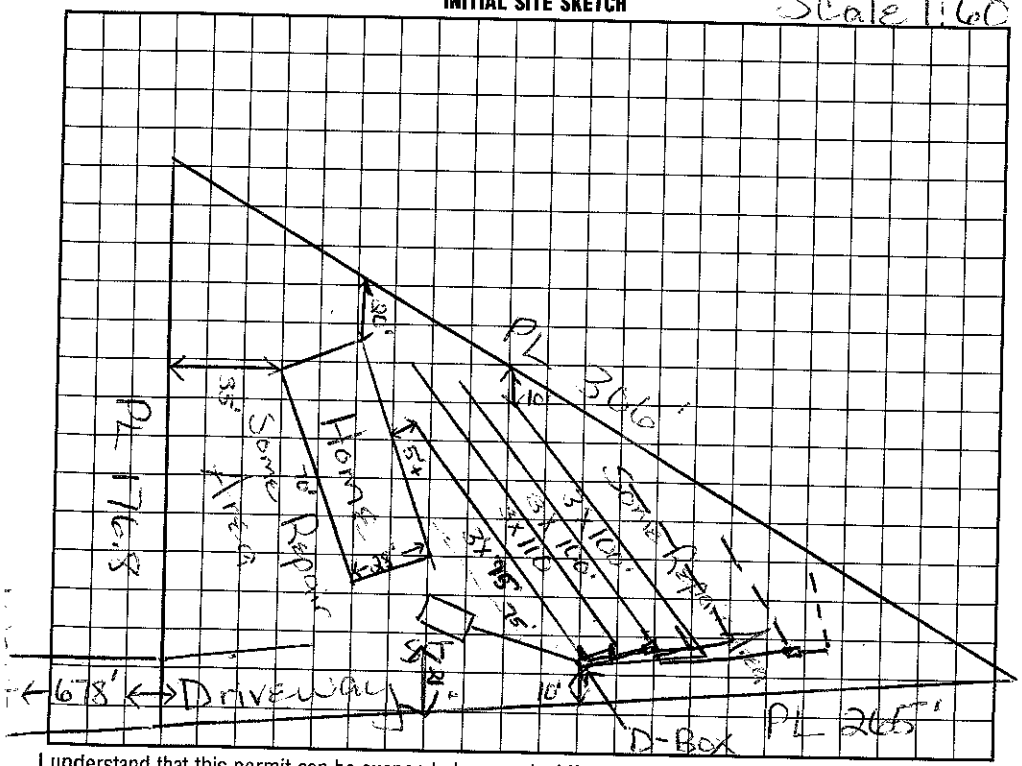

AS BUILT SKETCH

I understand that this permit can be suspended or revoked if any false information is supplied toward securing the permit/any unauthorized changes are made to the site/any unauthorized changes are made in the installation of the system. Improvement Permit with plat valid without expiration. Improvement Permit with site plan valid for sixty months. Authorization to Construct is valid for a period equal to that of Improvement Permit – not to exceed sixty months.

Signed: Betty L Owen date 9/30/98

Improvement Permit by: Marian H. H. Dotson date 9/29/98

Authorization to Construct by: Marian H. H. Dotson date 9/29/98

Installed by: Randy Miller

Operation Permit by: Wesley Perkins date 10/12/98

Existing System Inspection by: ____ date ____

HEALTH DEPT. COPY: WHITE INSPECTION COPY (FINAL): GREEN OWNER COPY (FINAL): YELLOW INSPECTION COPY (INITIAL): PINK OWNER COPY (INITIAL): GOLD