# IREDELL COUNTY HEALTH DEPARTMENT

STATESVILLE 704-878-5305 125.00 Paid MOORESVILLE 704-664-5281

## IMPROVEMENT PERMIT / AUTHORIZATION TO CONSTRUCT / OPERATION PERMIT / EXISTING SYSTEM INSPECTION

PERMIT# 087334 PIN# 4750 20 2569 4659298861 DATE 2/11/00

OWNER OR CONTRACTOR Henry Johnson PHONE: Business Home 528-4635

ADDRESS 172 Wits End Troutman, NC. 28166

LOCATION 115-21 N TR on Shinstone TL Wits End, middle fork to end of road

SUBDIVISION No BLOCK / SECTION LOT LOT AREA 2 2ac. SITE CLASS. 0 RS DESIGN FLOW 360 L.T.A.R. .3

Septic Tank: 1000 Gallons; STB 794 Date 4/16/01

Pump Tank: Gallons; PT Date

Pump Make: Model Serial No.

Nitrification Field: No Fields 1 Square Feet 900* Linear Feet 300*

No Lines 3 Trench Width 36" Max Trench Bottom Depth 30" Gravel Depth SAND

☒ New System ☐ Repair System Type: I, II, (III) IV, V, VI

System Description: Snow-Flo LDS or Chamber Plus.

Repair System Description: Same

Maintenance Agreement Required: ☐ Yes ☒ No

☐ House/Mod. Home ☒ Mobile Home ☐ Business ☐ Other

No. Bedrooms 3 No. Bathrooms 2 No. Employees


Water Supply: ☒ Individual ☐ Public ☐ Community Home on R

☐ Slab ☒ Crawl Space ☐ Basement w/plumbing ☐ Basement wo/plumbing


Comments:/Conditions: Inspection Ports Required *

Comments:/Conditions:

INITIAL SITE SKETCH

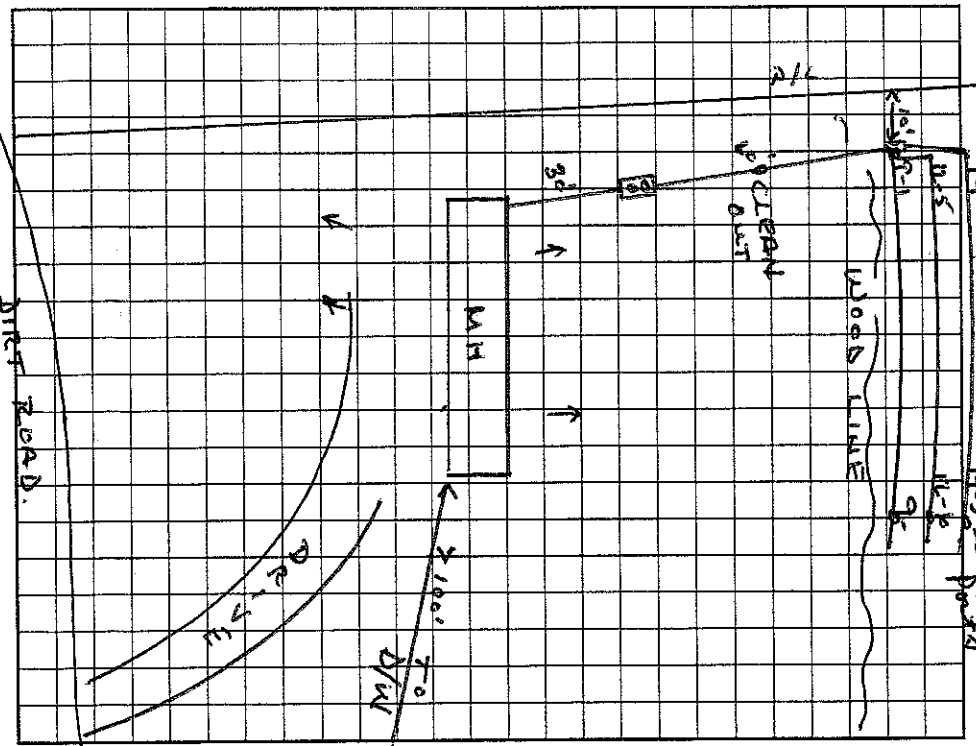


AS BUILT SKETCH

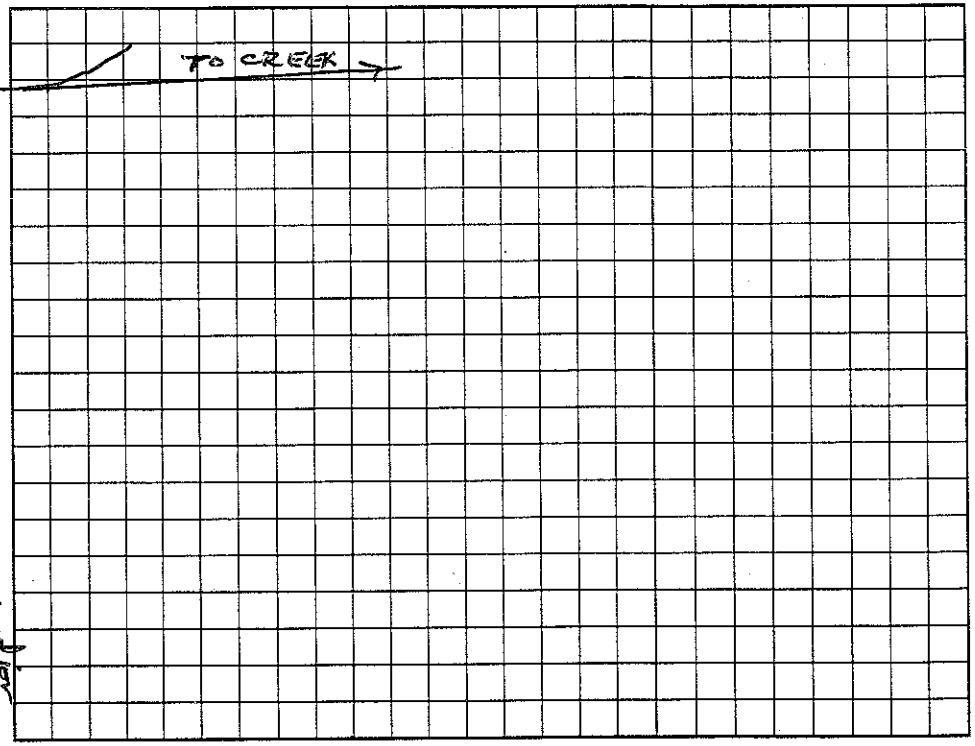


Permit can be suspended or revoked if any false information is supplied toward securing the permit/any unauthorized changes are made to the site/any unauthorized changes are made in the installation of the system. Improvement Permit with plat valid without expiration. Improvement Permit with site plan valid for sixty months. Authorization to Construct is valid for a period equal to that of Improvement Permit – not to exceed sixty months.

Signed: * 7-12-01 date

Improvement Permit by: Wesley Sparks RS. date 2/11/00

Authorization to Construct by: Wesley Sparks RS. date 2/11/00

Installed by: Andy Daniels

Operation Permit by: Wesley Sparks RS. date 7/31/01

Existing System Inspection by: date

HEALTH DEPT. COPY: WHITE OWNER COPY (FINAL): YELLOW OWNER COPY (INITIAL): PINK