IREDELL COUNTY HEALTH DEPARTMENT

STATESVILLE 704-878-5305 MOORESVILLE 704-664-5281

IMPROVEMENT PERMIT / AUTHORIZATION TO CONSTRUCT / OPERATION PERMIT / EXISTING SYSTEM INSPECTION

$700

PERMIT# 130216 PIN# 4659 31 7984 4659-31-7796 DATE 11/29/05

OWNER OR APPLICANT Bradley Mills PHONE: Business _____ Home _____

ADDRESS 162 M&M Farms Dr. Mooresville NC 28115

LOCATION 115 N, TL Barfield, on Lf

SUBDIVISION _____ BLOCK / SECTION _____ LOT _____ LOT AREA 2.745 Ac SITE CLASS. PS DESIGN FLOW 360 L.T.A.R. 0.25

Septic Tank: 1000 Gallons; STB 794 Date 2-27-09

Pump Tank: 1000 Gallons; PT 29 Date 3-21-09

Pump Make: _____ Model _____ Serial No. _____

Nitrification Field: No Fields 4 Square Feet 1080 Linear Feet 360

No Lines 5@72' Trench Width 36" Max Trench Bottom Depth 48" Gravel Depth — ☐ Gravity ☒ Pressure

☒ New System ☐ Repair ☐ Expansion System Type: I II (III) IV V VI

System Description: Pump 25% Reduction

Repair System Description: LP Panel Block

Maintenance Agreement Required: ☐ Yes ☒ No

☒ House/Mod. Home ☐ Mobile Home ☐ Business ☐ Other

No. Bedrooms 3 No. Persons ____ No. Employees ____


Water Supply: ☒ Individual ☐ Public ☐ Community

☐ Slab ☐ Crawl Space ☒ Basement w/plumbing ☐ Basement wo/plumbing


Comments:/Conditions:

Comments:/Conditions:

INITIAL SITE SKETCH

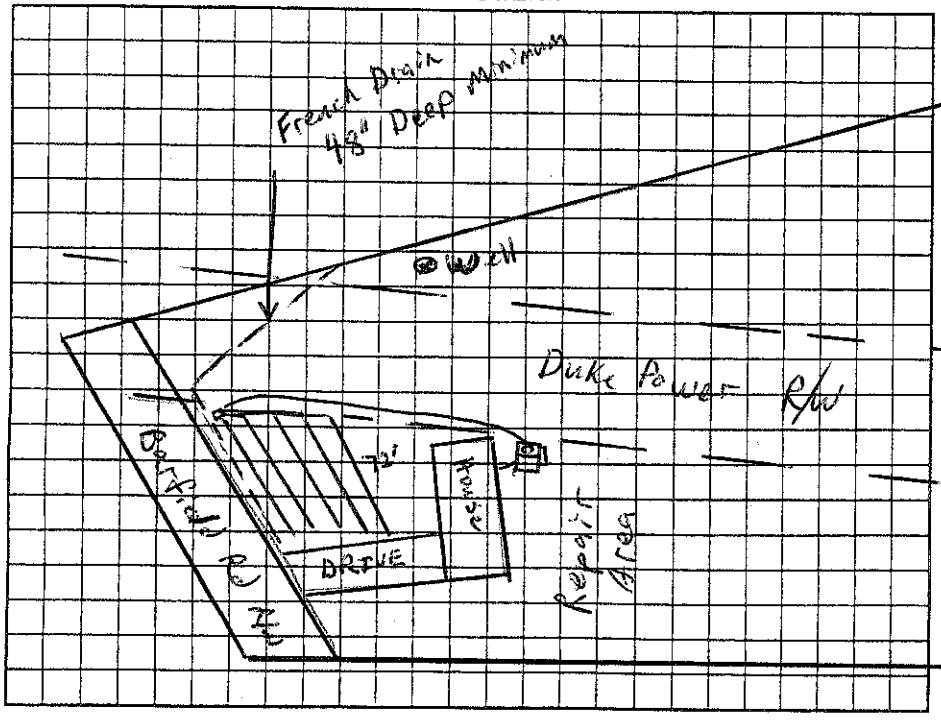

AS BUILT SKETCH

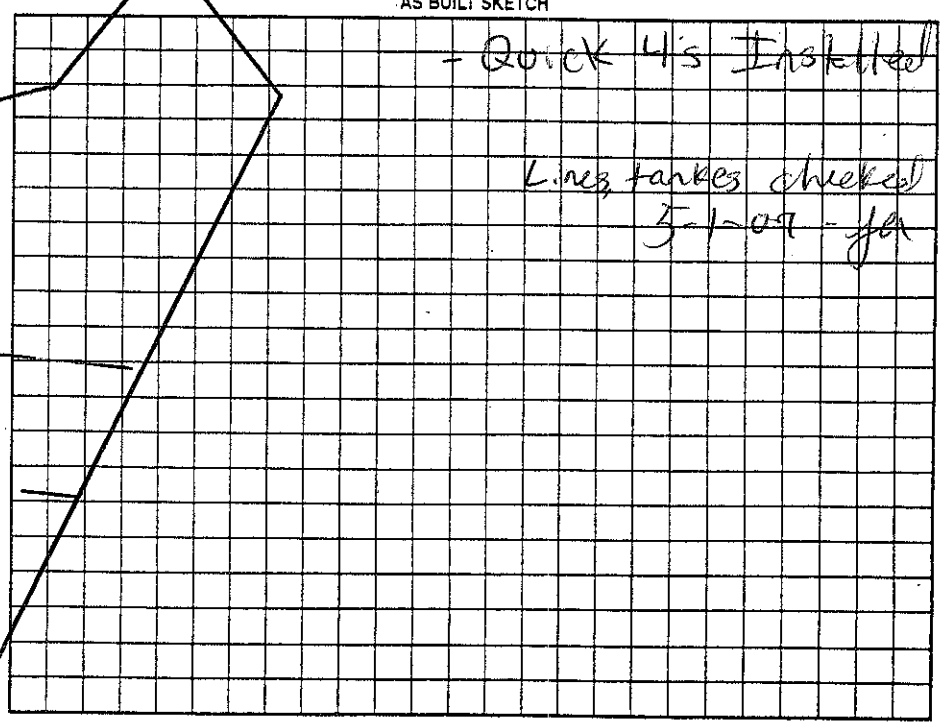

Permit can be suspended or revoked if any false information is supplied toward securing the permit/any unauthorized changes are made to the site/any unauthorized changes are made in the installation of the system. Improvement Permit with plat valid without expiration ☐ Improvement Permit with site plan valid for sixty months ☒ Authorization to Construct is valid for a period equal to that of Improvement Permit – not to exceed sixty months.

Signed: Bradley W. Mills date 12/9/05 Installed by: Marty Tucker

Improvement Permit by: RS date 11/29/05 Operation Permit by: John E Alph date 5-25-09

Authorization to Construct by: RS date 11/29/05 Existing System Inspection by: _____ date _____

HEALTH DEPT. COPY: WHITE OWNER COPY (FINAL): YELLOW OWNER COPY (INITIAL): PINK