IREDELL COUNTY HEALTH DEPARTMENT

Authorized to Construct

4659318378

STATESVILLE 704-878-5305 MOORESVILLE 704-664-5281

IMPROVEMENT PERMIT / ~~CERTIFICATE OF COMPLETION~~ / OPERATION PERMIT / EXISTING SYSTEM INSPECTION

PROPERTY DESCRIPTION NO. 15106 DATE 12/5/95 TAX MAP NO. 1R A 253

OWNER OR CONTRACTOR Lois McDaniels PHONE: Business Watershed: ☐ Yes ☒ No

ADDRESS PO Box 594 Mooresville, NC. 28115 Home 664-1733

LOCATION 115N TL Barfield Rd. TL first gravel road to 3RD home on (L)

SUBDIVISION BLOCK SECTION LOT LOT AREA 200 x 280' SITE CLASS. PS DESIGN FLOW 360 L.T.A.R. .35

Septic Tank: 1000 Gallons; STB 1027 Date 10/1/95

Pump Tank: Gallons; PT Date

Pump Make: Model Serial No.

Nitrification Field: No Fields 1 Square Feet 1028 Linear Feet 345

No Lines 3 Trench Width 36" Max Trench Bottom Depth 36" Gravel Depth 12"

☒ New System ☐ Repair System Type: I, II, III, IV, V, VI

System Description: CONN - DIST BOX

Repair System Description:

Maintenance Agreement Required: ☐ Yes ☐ No

☒ House/Mod. Home No. Bedrooms 3

☐ Mobile Home No. Bathrooms 3

☐ Business No. Employees

☐ Other


☐ Slab ☒ Crawl Space ☐ Basement w/plumbing ☐ Basement wo/plumbing

Water Supply: ☒ Individual ☐ Community ☐ Public


Comments:

Comments:

INITIAL SITE SKETCH

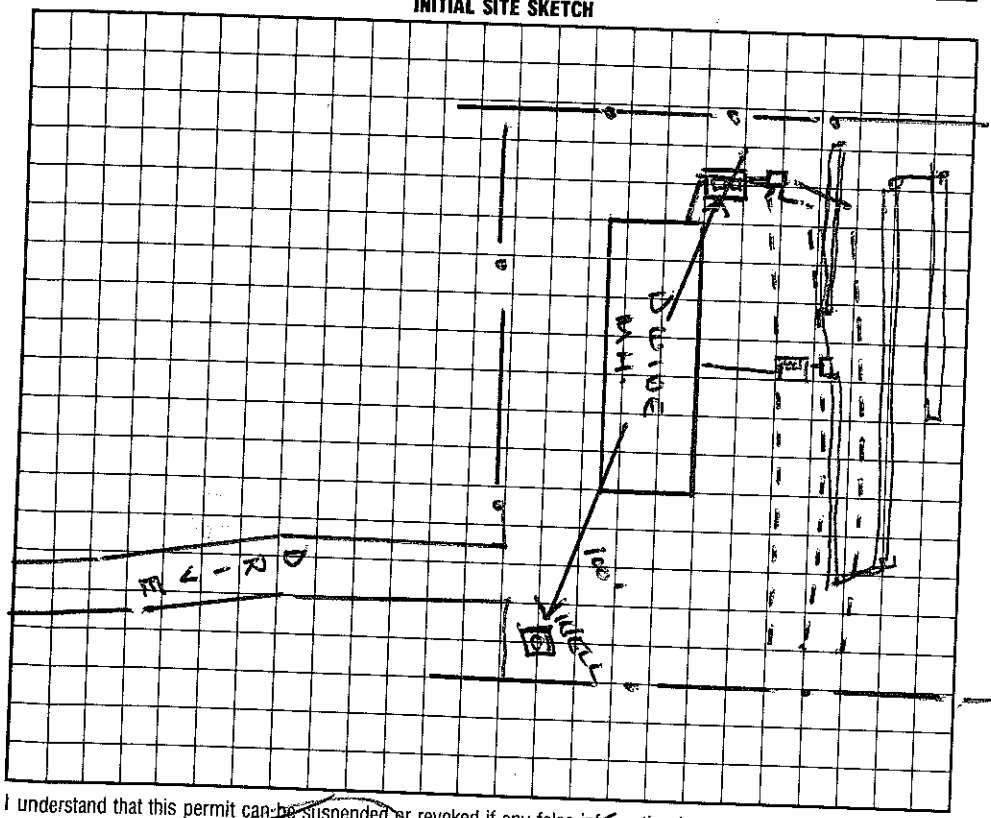

AS BUILT SKETCH

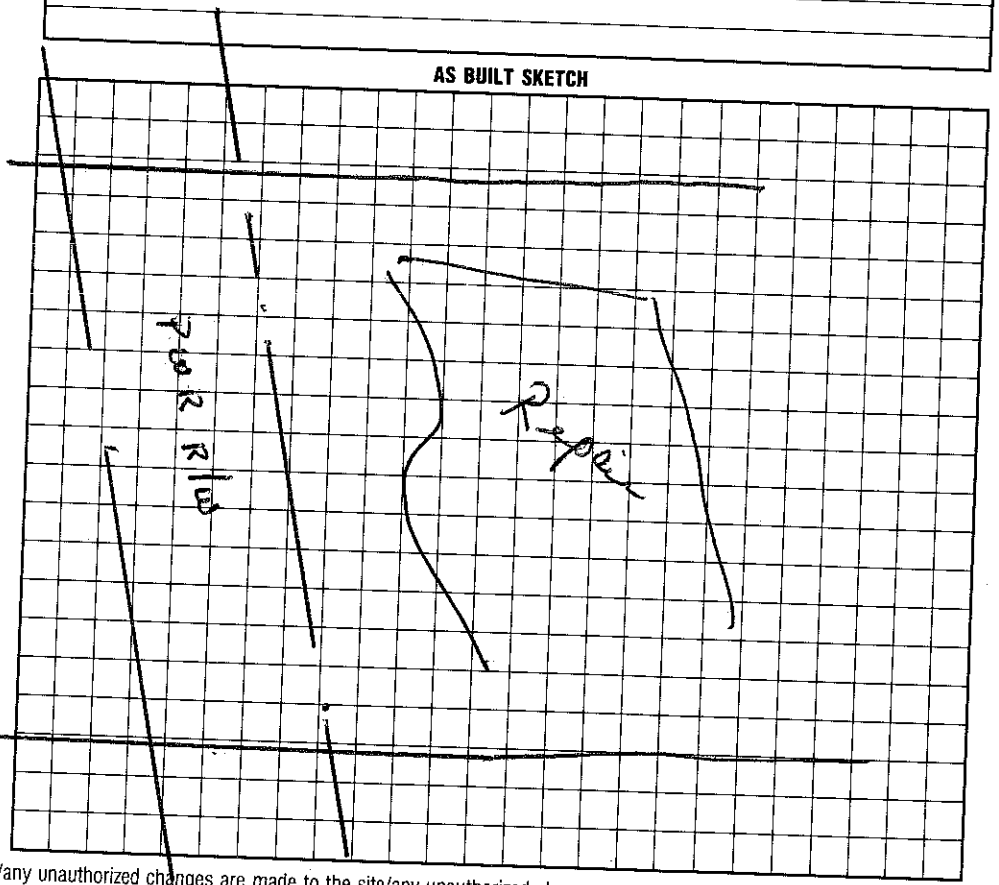

I understand that this permit can be suspended or revoked if any false information is supplied toward securing the permit/any unauthorized changes are made to the site/any unauthorized changes are made in the installation of the system.

Signed:

Improvement Permit by: Wesley Sparks RS. date 12/5/95

Existing System Inspection by: Construct Wesley Sparks RS 12/5/95

Installed by: Forest Shuford

Certificate of Completion by: Wesley Sparks RS date 1/17/96

Operation Permit by: Wesley Sparks RS date 1/17/96

HEALTH DEPT. COPY: WHITE INSPECTION COPY (FINAL): GREEN OWNER COPY (FINAL): YELLOW INSPECTION COPY (INITIAL): PINK OWNER COPY (INITIAL): GOLD