4659320238

IREDELL COUNTY HEALTH DEPARTMENT

STATESVILLE 704-878-5305 MOORESVILLE 704-664-5281

IMPROVEMENT PERMIT / CERTIFICATE OF COMPLETION / OPERATION PERMIT / EXISTING SYSTEM INSPECTI

PROPERTY DESCRIPTION NO. 23006 DATE 1-20-96 TAX MAP NO. 1R-2-A-4 Watershed: ☐ WA ☐ Nr

OWNER OR CONTRACTOR ED BROOKS Tommy Messick PHONE: Business 664-2582 Home 876-4141

ADDRESS 189 AUSTIN RD STATESVILLE NC 28677 137 Lowgn Haven Mooresville

LOCATION US 21 N, TL BARFIELD ROAD, ON R JUST PAST M & M FARMS DRIVE.

SUBDIVISION PARKS CORNELIUS BLOCK / SECTION ____ LOT 4 LOT AREA 5.47 ACRES SITE CLASS. PS DESIGN FLOW 360 L.T.A.R. 0.30 GPD/FT²

Septic Tank: 1000 Gallons; STB 794 Date 4/18/98

Pump Tank: ____ Gallons; PT ____ Date ____

Pump Make: ____ Model ____ Serial No. ____

Nitrification Field: No Fields 1 Square Feet 1200 Linear Feet 400

No Lines 4 Trench Width 36" Max Trench Bottom Depth 18-36" Gravel Depth 12"

☑ New System ☐ Repair System Type: I, II, III, IV, V, VI

System Description: CONVENTIONAL-GRAVITY

Repair System Description: CONVENTIONAL GRAVITY

Maintenance Agreement Required: ☐ Yes ☑ No

☑ House/Mod. Home No. Bedrooms 3

☐ Mobile Home No. Bathrooms 2+

☐ Business No. Employees ____

☐ Other ____


☐ Slab ☑ Crawl Space ☐ Basement w/plumbing ☐ Basement wo/plumbing

Water Supply: ☑ Individual ☐ Community ☐ Public WELL

Comments: ① USE THREE FLOW DIVIDER TEES TO ACHIEVE EQUAL DISTRIBUTION INTO EACH OF FOUR 100' LINES ② INSTALL LINES AS SHOWN; ON CONTOUR, NO DEEPER THAN 36" 9' MINIMUM APART ON CENTERS ③ KEEP SYSTEM MINIMUM 100' FROM WELL

Comments: OK to put well to right side of Driveway- 100' from Septic System.

INITIAL SITE SKETCH

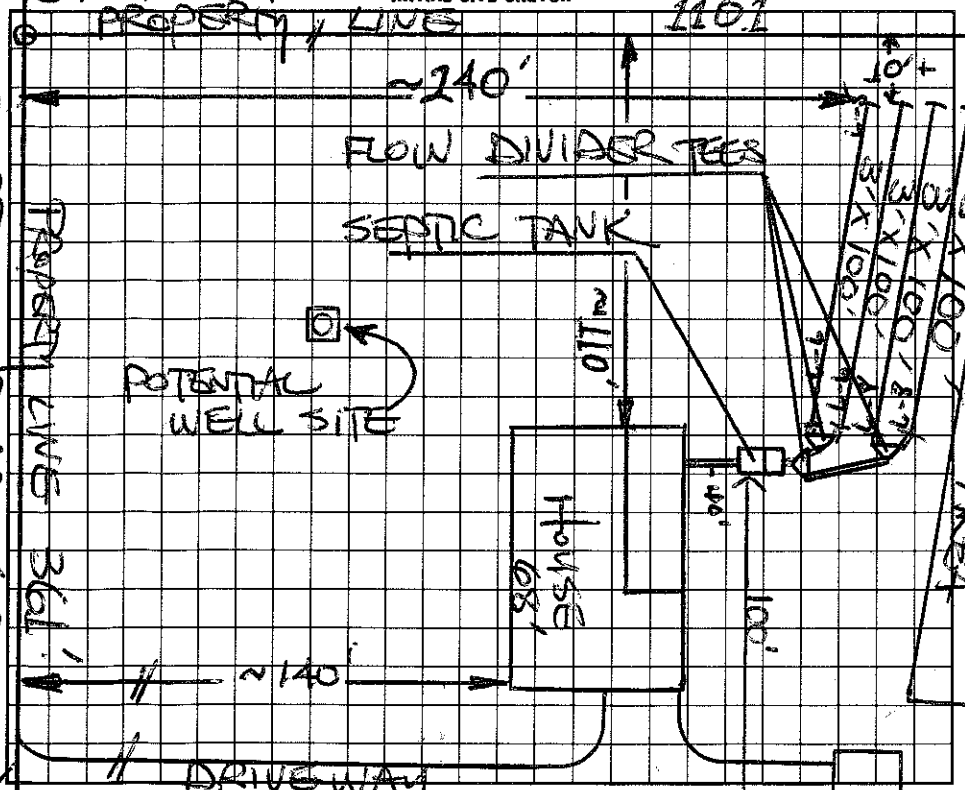

AS BUILT SKETCH

I understand that this permit can be suspended or revoked if any false information is supplied toward securing the permit/any unauthorized changes are made to the site/any unauthorized changes are made in the installation of the system.

AUTHORIZATION TO CONSTRUCT IS VALID FIVE (5) YEARS FROM DATE OF ISSUANCE. IMPROVEMENT PERMIT HAS NO EXPIRATION DATE.

Signed: X Edward Brooks

Improvement Permit by: STEVE HENRICK date 1-20-96

AUTHORIZATION TO CONSTRUCT

Existing System Inspection by: STEVE HENRICK date 1-20-96

Installed by: Eddie Nantz

Certificate of Completion by: Wesley Sparks R.S. date 7/6/98

Operation Permit by: Wesley Sparks R.S. date 7/6/98

HEALTH DEPT. COPY: WHITE INSPECTION COPY (FINAL): GREEN OWNER COPY (FINAL): YELLOW INSPECTION COPY (INITIAL): PINK OWNER COPY (INITIAL): GOLD

Marie H. Wilkerson 11/6/97