4659-34-3497

IREDELL COUNTY HEALTH DEPARTMENT

STATESVILLE 704-878-5305 MOORESVILLE 704-664-5281

IMPROVEMENT PERMIT / CERTIFICATE OF COMPLETION / OPERATION PERMIT / EXISTING SYSTEM INSPECTION

PROPERTY DESCRIPTION NO. 18959 DATE 8/19/94 TAX MAP NO. 4E-4-1 Watershed: ☐ Yes ☑ No

OWNER OR CONTRACTOR Edward P Farmer PHONE: Business _____ Home 663-3716

ADDRESS 428 W. Center Ave Mooresville, NC, 28115

LOCATION Freeze Dr. Rd, R off 115N to 1st Lot on R

SUBDIVISION Freeze Dr. BLOCK / SECTION _____ LOT 1 LOT AREA ~.73 AC SITE CLASS. P DESIGN FLOW 360 L.T.A.R. .25-.3

Septic Tank: 1000 Gallons; STB 1012 Tp Date 7-1-94

Pump Tank: _____ Gallons; PT _____ Date _____

Pump Make: _____ Model _____ Serial No. _____

Nitrification Field: No Fields 1 Square Feet _____ Linear Feet 210 LF

No Lines 3 Trench Width 24" Max Trench Bottom Depth 36" Gravel Depth 6" SAND

☑ New System ☐ Repair System Type: I, II, III, IV, V, VI

System Description: GRAVITY PPBS

Repair System Description: PRESSURE PPBS

Maintenance Agreement Required: ☐ Yes ☑ No

☐ House/Mod. Home No. Bedrooms 3

☑ Mobile Home No. Bathrooms 2

☐ Business No. Employees _____

☐ Other _____


☐ Slab ☑ Crawl Space ☐ Basement w/plumbing ☐ Basement wo/plumbing

Water Supply: ☑ Individual ☐ Community ☐ Public


Comments:
16' PPBS DRAINLINES
DIST BOX
PRESSURE REPAIR

Comments: Need extra cover over upper lateral.

INITIAL SITE SKETCH

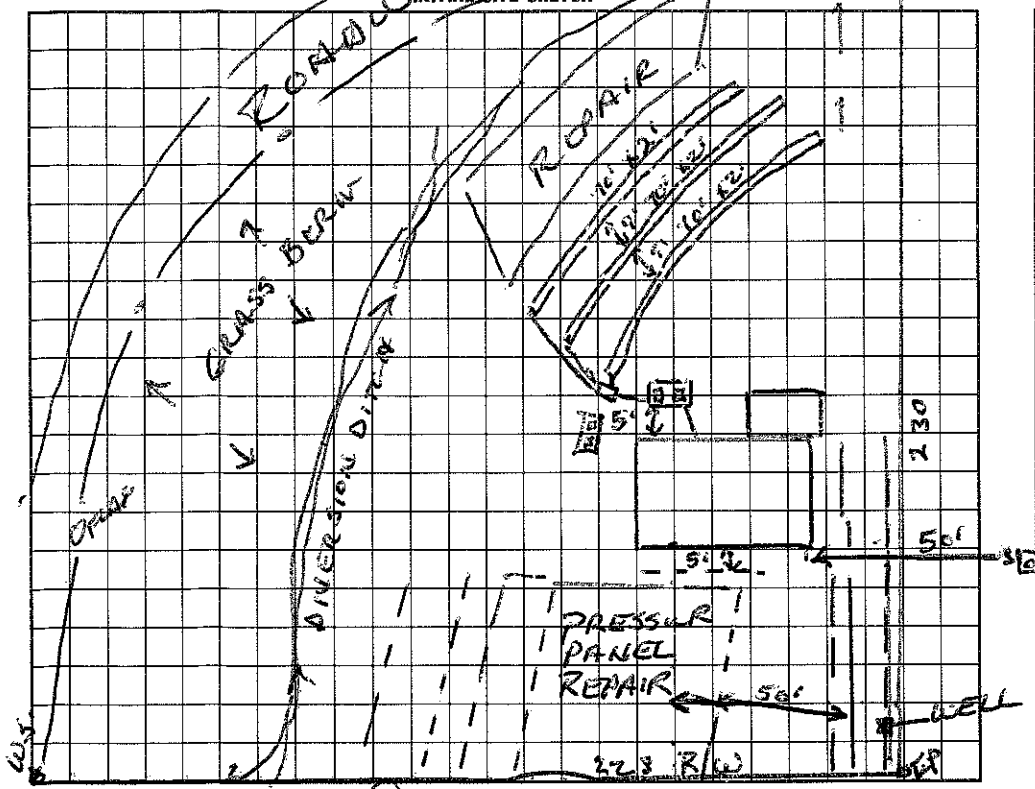

AS BUILT SKETCH

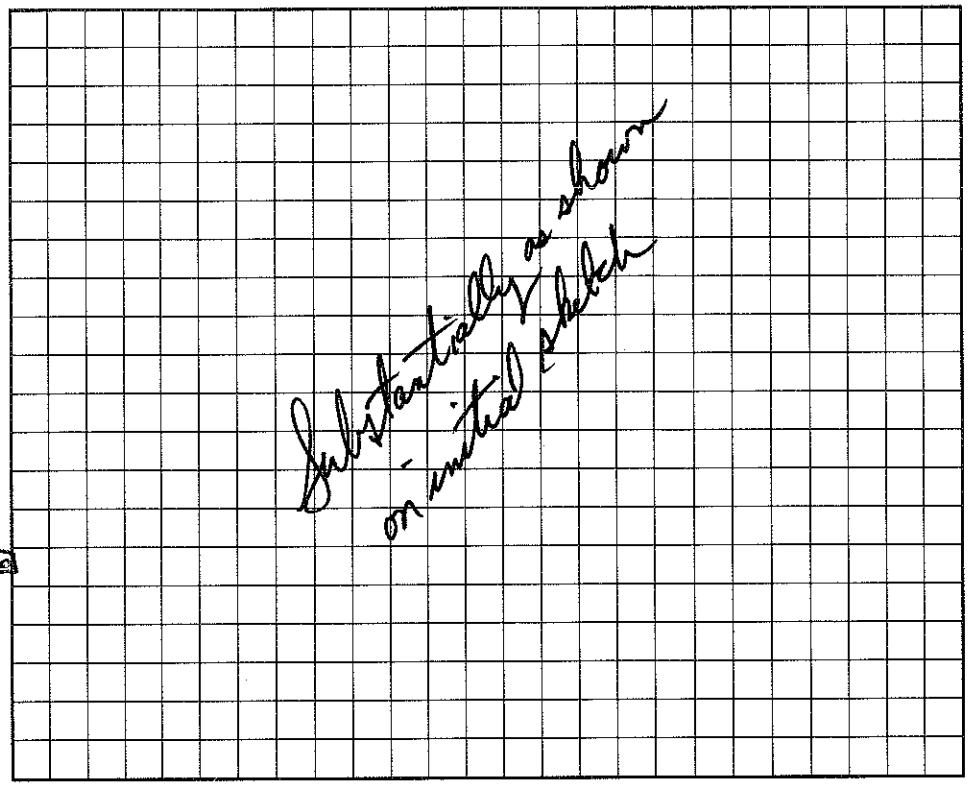

I understand that this permit can be suspended or revoked if any false information is supplied toward securing the permit/any unauthorized changes are made to the site/any unauthorized changes are made in the installation of the system. Improvement Permit is valid for 60 months from date of issuance. FREEZE DR.

Signed: _____

Improvement Permit by: Wesley Sparks RS. date 8/19/94

Existing System Inspection by: _____ date _____

Installed by: Donald Jackey

Certificate of Completion by: _____ date _____

Operation Permit by: James R. Hinson, RS date 9-21-94

HEALTH DEPT. COPY: WHITE INSPECTION COPY (FINAL): GREEN OWNER COPY (FINAL): YELLOW INSPECTION COPY (INITIAL): PINK OWNER COPY (INITIAL): GOLD