IREDELL COUNTY HEALTH DEPARTMENT

STATESVILLE 704-878-5305 MOORESVILLE 704-664-5281

IMPROVEMENT PERMIT / CERTIFICATE OF COMPLETION / OPERATION PERMIT / EXISTING SYSTEM INSPECTION

PROPERTY DESCRIPTION NO. 16914 DATE 9/1/93 TAX MAP NO. 4L-4-A-32

OWNER OR CONTRACTOR ELBERT THORNSBERRY ~~PHONE: Business~~ PIN# 4659-34-4277 Home 663-0839

ADDRESS R+1 720-9 MOORESVILLE, NC.

LOCATION 115 N, TR INTO FREEZE KING TO FIRST LOT ON (R)

SUBDIVISION FREEZE KING BLOCK / SECTION _____ LOT 32 LOT AREA 720,000 FT² SITE CLASS. P. L.T.A.R. .25-.3

Water Supply: ☑ Individual ☐ Community ☐ Public

Septic Tank: 1000 Gallons; STB 921 Date 3/22/95

Pump Tank: _____ Gallons; PT _____ Date _____

Nitrification Field: No Fields 1 Square Feet 1200 Linear Feet 400

No Lines 4 Trench Width 3' Trench Depth 36" Gravel Depth 12"

☑ New System ☐ Repair System Type: I (II) II, IV, V, VI

System Description: CONV - GRAVITY

Repair System Description: _____

Maintenance Agreement Required: ☐ Yes ☑ No

☑ House/Mod. Home No. Bedrooms 3 Garbage Disposal: ☐ Yes ☑ No

☐ Mobile Home No. Bathrooms 2 Auto. Dishwasher: ☑ Yes ☐ No


☐ Business No. Employees _____ Auto. Washing Machine: ☑ Yes ☐ No

☐ Other _____ Other _____

☐ Slab ☑ Crawl Space ☐ Basement w/plumbing ☐ Basement wo/plumbing

Comments Keep trenches no deeper than 36" to trench bottom. Lines on slope contour in direction shown.

INITIAL SITE SKETCH

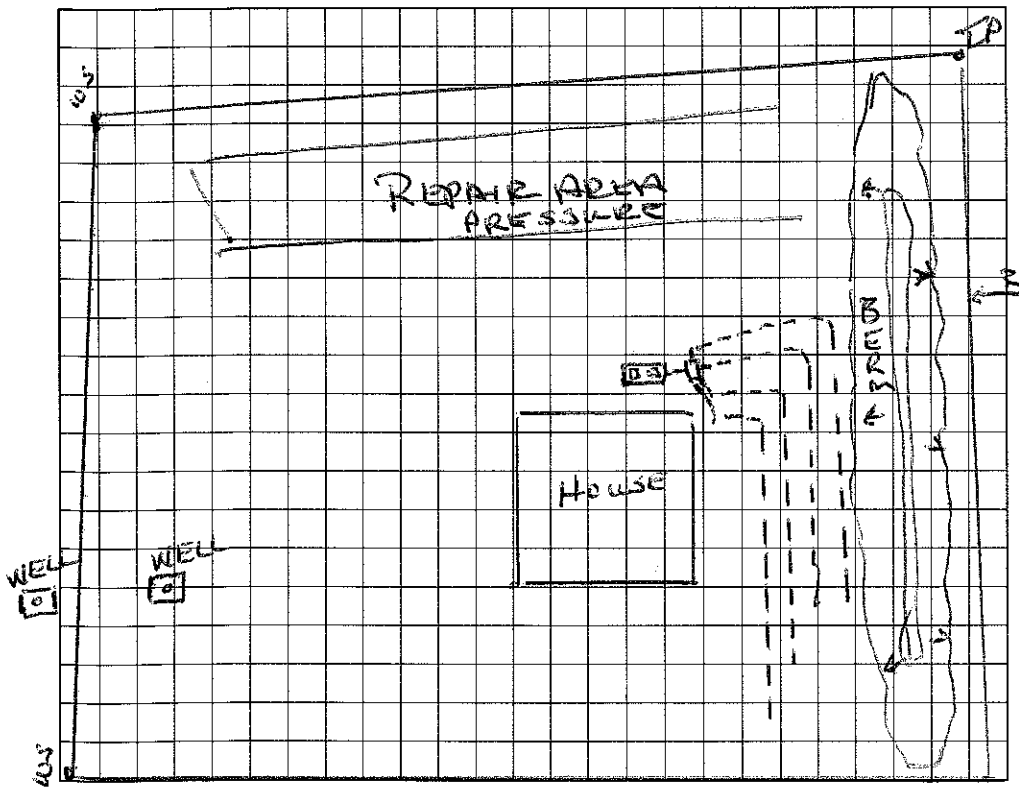

AS BUILT SKETCH

Installed as shown on Improvement Permit

I understand that this permit can be suspended or revoked if any false information is supplied toward securing the permit/any unauthorized changes are made to the site/any unauthorized changes are made in the installation of the system. Improvement Permit is valid for 60 months from date of issuance.

Signed: X Elbert Thornsberry

Improvement Permit by: Wesley Sparks RS. date 9/1/93

Existing System Inspection by: _____ date _____

Installed by: B+M Contracting

Certificate of Completion by: Wesley Sparks RS. date 4/21/95

Operation Permit by: _____ date _____

HEALTH DEPT. COPY: WHITE INSPECTION COPY (FINAL): GREEN OWNER COPY (FINAL): YELLOW INSPECTION COPY (INITIAL): PINK OWNER COPY (INITIAL): GOLD