IREDELL COUNTY HEALTH DEPARTMENT

AUTHORIZATION TO CONSTRUCT

11:00

STATESVILLE 704-878-5305 MOORESVILLE 704-664-5281

IMPROVEMENT PERMIT / ~~CERTIFICATE OF COMPLETION~~ / OPERATION PERMIT / EXISTING SYSTEM INSPECTION

PROPERTY DESCRIPTION NO. 17463 DATE 3/21/97 TAX MAP NO. 4659 34 4953 Watershed: ☐ Yes ☑ No

OWNER OR CONTRACTOR JOHNNY C. SELLS PHONE: Business _____ Home 528-9437

ADDRESS 107 ED'S LN STATESVILLE

LOCATION 21/115 N - TR FREEZE CROSSING - GO LEFT AT FORK PAST BRICK CHURCH - 1ST LOT ON LEFT

SUBDIVISION — BLOCK / SECTION — LOT — LOT AREA 2.766 AC SITE CLASS. RS DESIGN FLOW 360 GAD L.T.A.R. .36 PD/FT²

Septic Tank: 1000 Gallons; STB 1012 Date 5/19/97

Pump Tank: _____ Gallons; PT _____ Date _____

Pump Make: _____ Model _____ Serial No. _____

Nitrification Field: No Fields 1 Square Feet 1200 Linear Feet 400

No Lines 4@100 Trench Width 36" Max Trench Bottom Depth 30" Gravel Depth 12"

☑ New System ☐ Repair System Type: I, II, III, IV, V, VI

System Description: GRAVITY CONVENTIONAL

Repair System Description: SAME

Maintenance Agreement Required: ☐ Yes ☑ No

☑ House/Mod. Home No. Bedrooms 3

☐ Mobile Home No. Bathrooms 2

☐ Business No. Employees _____

☐ Other _____


☐ Slab ☑ Crawl Space ☐ Basement w/plumbing ☐ Basement wo/plumbing

Water Supply: ☑ Individual ☐ Community ☐ Public


Comments: HOUSE MAY BE MOVED 20' TOWARD CEDARCREST DRIVE.

Comments:

INITIAL SITE SKETCH 1"=100'

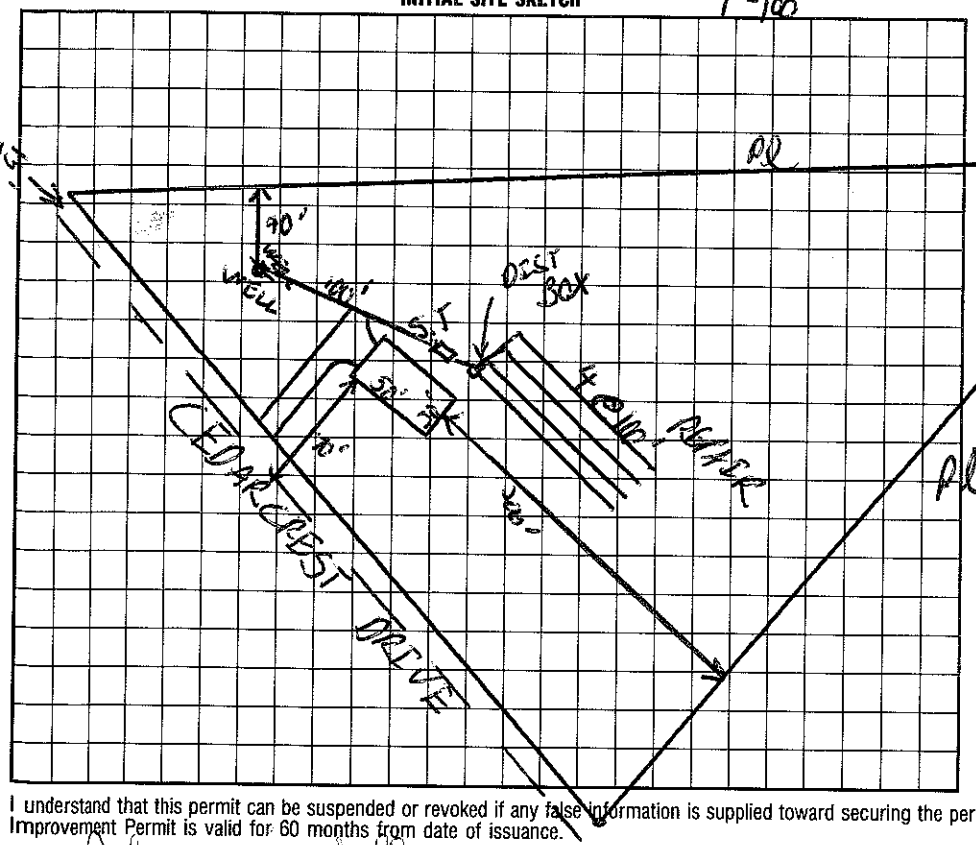

AS BUILT SKETCH

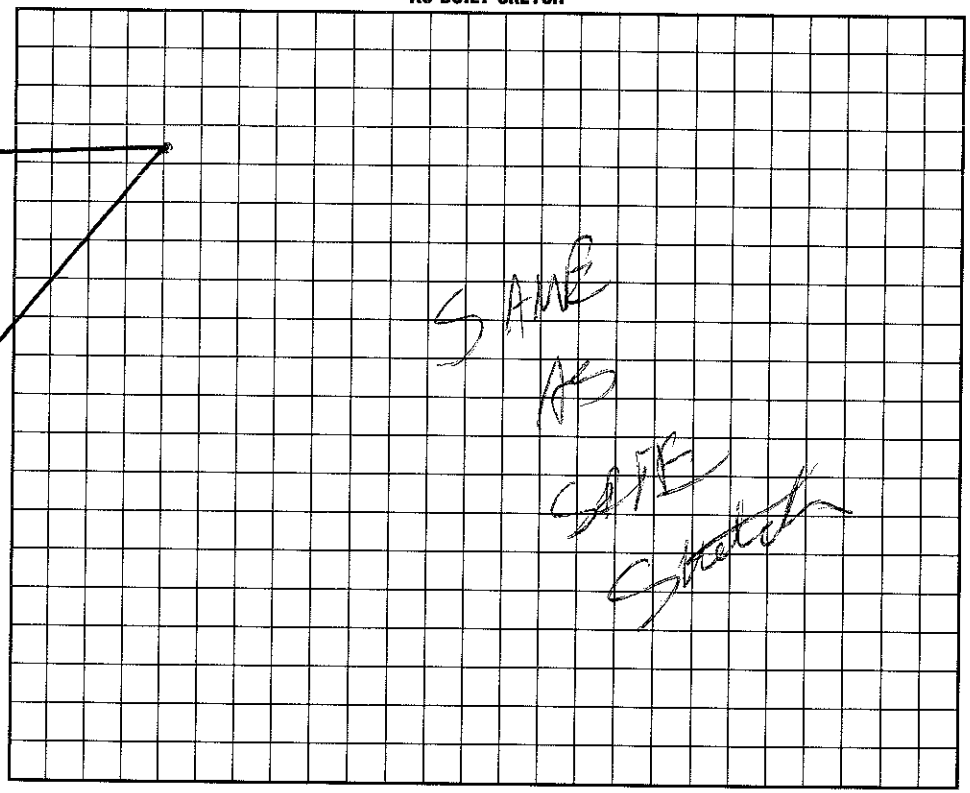

I understand that this permit can be suspended or revoked if any false information is supplied toward securing the permit/any unauthorized changes are made to the site/any unauthorized changes are made in the installation of the system. Improvement Permit is valid for 60 months from date of issuance.

Signed: Johnny C Sells

Improvement Permit by: EHS date 3/21/97

AUTHORIZATION TO CONSTRUCT Existing System Inspection by: EHS date 3/21/97

Installed by: DONALD LAWLEY

Certificate of Completion by: _____ date _____

Operation Permit by: _____ date 7/18/97

HEALTH DEPT. COPY: WHITE INSPECTION COPY (FINAL): GREEN OWNER COPY (FINAL): YELLOW INSPECTION COPY (INITIAL): PINK OWNER COPY (INITIAL): GOLD