4659-34-5507

IREDELL COUNTY HEALTH DEPARTMENT

STATESVILLE 704-878-5305 MOORESVILLE 704-664-5281

IMPROVEMENT PERMIT / CERTIFICATE OF COMPLETION / OPERATION PERMIT / EXISTING SYSTEM INSPECTION

PROPERTY DESCRIPTION NO. 17629 DATE 12/30/93 TAX MAP NO. 4E 4 A 2 Watershed: ☐ Yes ☒ No

OWNER OR CONTRACTOR ROBERT WATSON PHONE: Business _____ Home 892-7377

ADDRESS Rt 11 Box 1318 Mooresville NC. 28115

LOCATION FREEZE CROSSING - FREEZE DR.

SUBDIVISION FREEZE CROSSING BLOCK / SECTION _____ LOT 2 LOT AREA 2.170 AC SITE CLASS. P DESIGN FLOW 360 L.T.A.R. .25

Septic Tank: 1000 Gallons; STB 794 Date 11/23/93
Pump Tank: _____ Gallons; PT _____ Date _____
Pump Make: _____ Model _____ Serial No. _____
Nitrification Field: No Fields 1 Square Feet 1440 Linear Feet 480
No Lines 4 Trench Width 3' Max Trench Bottom Depth 32-34" Gravel Depth 12"

☒ New System ☐ Repair System Type: I (II) III, IV, V, VI
System Description: CONV - DROP BOXES
Repair System Description: SAME
Maintenance Agreement Required: ☐ Yes ☒ No


☐ House/Mod. Home No. Bedrooms 3
☒ Mobile Home No. Bathrooms 2
☐ Business No. Employees ____
☐ Other _____
☐ Slab ☒ Crawl Space ☐ Basement w/plumbing ☐ Basement wo/plumbing

Water Supply: ☒ Individual ☐ Community ☐ Public


Comments: MAXIMUM TRENCH DEPTH 34"
LINES ON CONTOUR, TO RUN IN DIRECTION SHOWN HERE.

Comments:

INITIAL SITE SKETCH

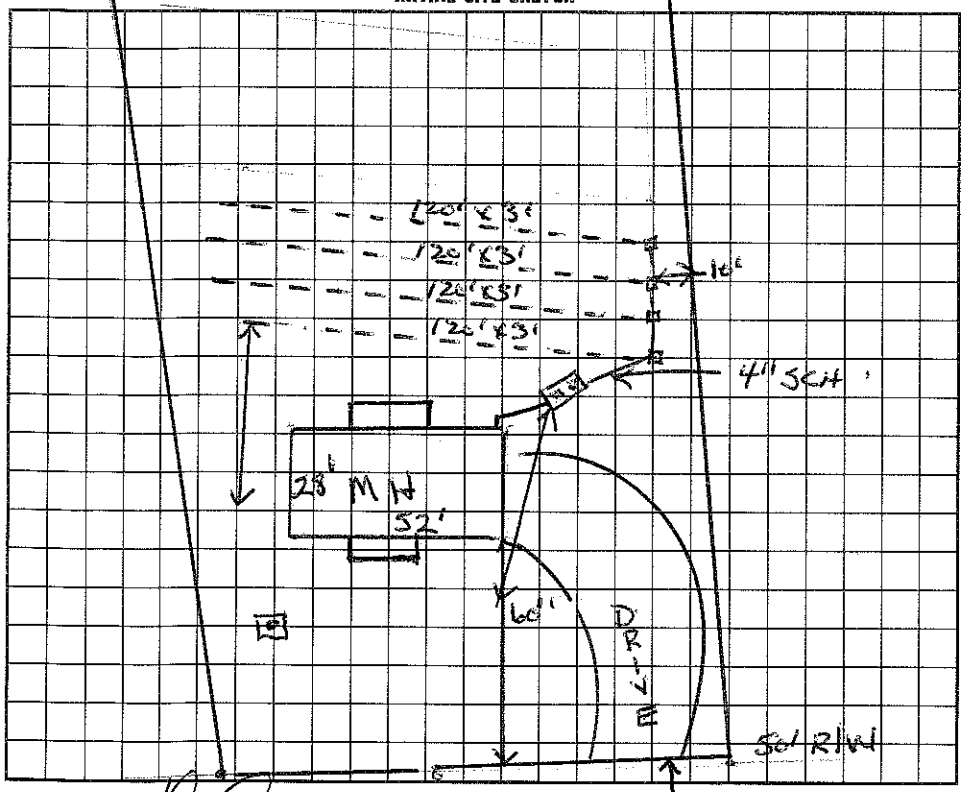

AS BUILT SKETCH

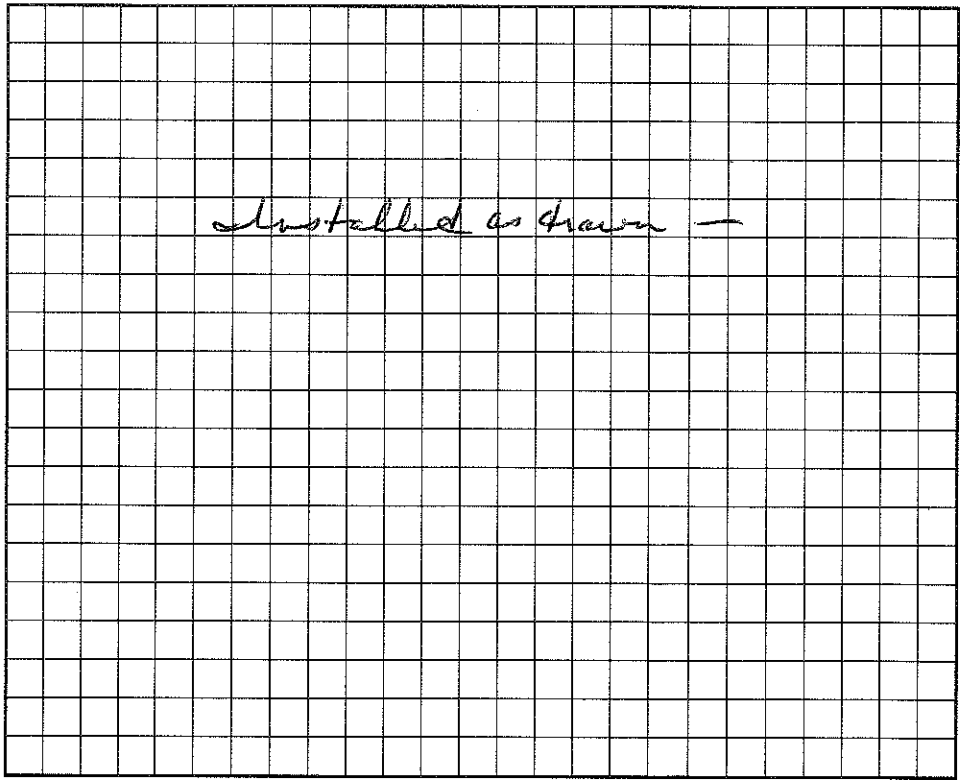

I understand that this permit can be suspended or revoked if any false information is supplied toward securing the permit/any unauthorized changes are made to the site/any unauthorized changes are made in the installation of the system. Improvement Permit is valid for 60 months from date of issuance. FREEZE RD.

Signed: _____

Improvement Permit by: Wesley Sparks R.S. date 12/30/93

Existing System Inspection by: _____ date _____

Installed by: Thom House Backhoe

Certificate of Completion by: Wesley Sparks R.S. date 3/11/94

Operation Permit by: _____ date _____

HEALTH DEPT. COPY: WHITE INSPECTION COPY (FINAL): GREEN OWNER COPY (FINAL): YELLOW INSPECTION COPY (INITIAL): PINK OWNER COPY (INITIAL): GOLD