4659-34-6633

IREDELL COUNTY HEALTH DEPARTMENT

STATESVILLE 704-878-5305 MOORESVILLE 704-664-5281

IMPROVEMENT PERMIT / CERTIFICATE OF COMPLETION / OPERATION PERMIT / EXISTING SYSTEM INSPECTION

PROPERTY DESCRIPTION NO. 13091 DATE 3/25/94 TAX MAP NO. 4E-4-A-3 Watershed: ☐ Yes ☑ No

OWNER OR CONTRACTOR Donald Presgley PHONE: Business _____ Home 704-398-1086

ADDRESS 923 Landsdowne Ct. Charlotte NC. 28214

LOCATION Freeze Rd. 115 N TR TO 3RD Left on (L)

SUBDIVISION Freeze Acres BLOCK / SECTION 1 LOT 3 LOT AREA +/- 1.61 AC SITE CLASS. P DESIGN FLOW 360 L.T.A.R. .3

Septic Tank: 1000 Gallons; PT 103 Date 3/16/~~94~~

Pump Tank: _____ Gallons; PT _____ Date _____

Pump Make: _____ Model _____ Serial No. _____

Nitrification Field: No Fields 1 Square Feet 1200 Linear Feet 400

No Lines 4 Trench Width 3' Max Trench Bottom Depth 3' Gravel Depth 12"

☑ New System ☐ Repair System Type: I (II) III, IV, V, VI

System Description: CONV - DROP BOXES

Repair System Description: GRAVITY PANEL

Maintenance Agreement Required: ☐ Yes ☑ No

☑ House/Mod. Home No. Bedrooms 3

☐ Mobile Home No. Bathrooms 2

☐ Business No. Employees ____

☐ Other _____


☐ Slab ☑ Crawl Space ☐ Basement w/plumbing ☐ Basement wo/plumbing

Water Supply: ☑ Individual ☐ Community ☐ Public

Comments:

Comments:
10 - LARRY SULLIVAN
4 - BLAINE BROWN

INITIAL SITE SKETCH

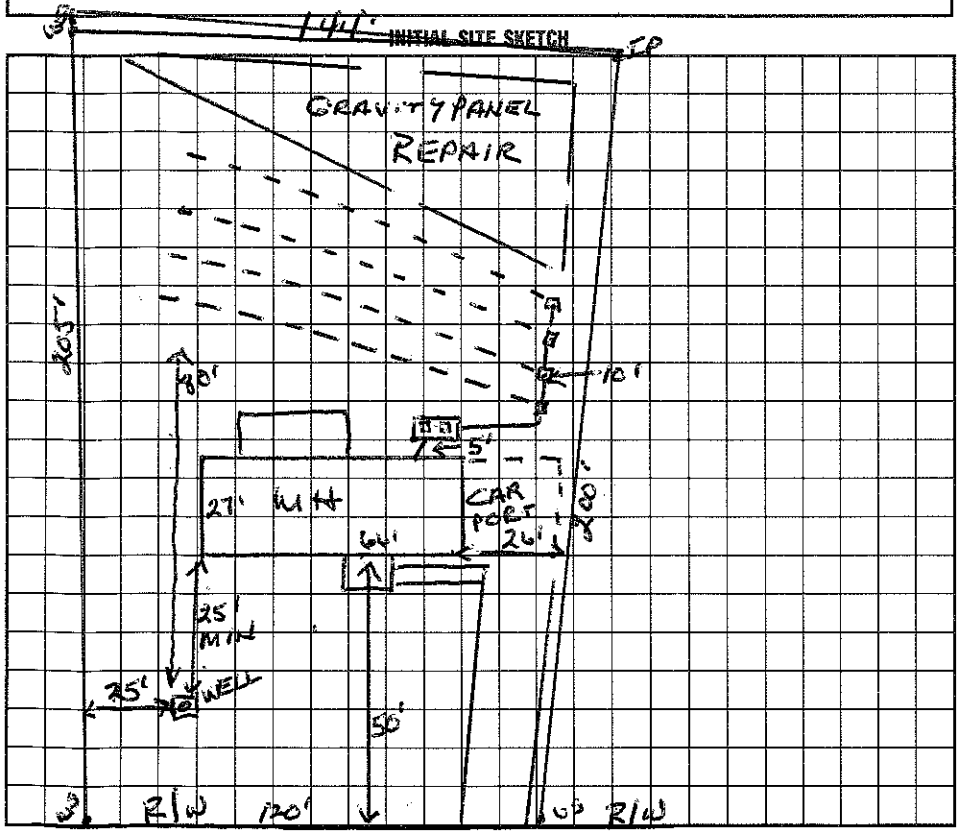

AS BUILT SKETCH

I understand that this permit can be suspended or revoked if any false information is supplied toward securing the permit/any unauthorized changes are made to the site/any unauthorized changes are made in the installation of the system. Improvement Permit is valid for 60 months from date of issuance.

Signed: Donald A Presgley

Improvement Permit by: Wesley Sparks RS date 3/25/94

Existing System Inspection by: _____ date _____

Installed by: Dennis Gallihen

Certificate of Completion by: Wesley Sparks RS date 4/19/94

Operation Permit by: _____ date _____

HEALTH DEPT. COPY: WHITE INSPECTION COPY (FINAL): GREEN OWNER COPY (FINAL): YELLOW INSPECTION COPY (INITIAL): PINK OWNER COPY (INITIAL): GOLD