IREDELL COUNTY HEALTH DEPARTMENT

4659-34-8415

STATESVILLE 704-878-5305 MOORESVILLE 704-664-5281

IMPROVEMENT PERMIT / CERTIFICATE OF COMPLETION / OPERATION PERMIT / EXISTING SYSTEM INSPECTION

PROPERTY DESCRIPTION NO. 17846 DATE 2/23/94 TAX MAP NO. 4E-4-A-30 Watershed: ☐ Yes ☒ No

OWNER OR CONTRACTOR ERIC SLACK (MICHAEL REDFIELD) PHONE: Business _____ Home 664-5146

ADDRESS PO BOX 33 TROUTMAN NC. 28166

LOCATION FREEZE RD, 11.5 N - TR FREEZE RD, 3RD LOT ON (R)

SUBDIVISION FREEZE CROSSING BLOCK / SECTION 1 LOT 30 LOT AREA ~.69AC SITE CLASS. P DESIGN FLOW 360 L.T.A.R. .3

Septic Tank: 1000 Gallons; STB 780 Date 3-2-93
Pump Tank: _____ Gallons; PT _____ Date _____
Pump Make: _____ Model _____ Serial No. _____
Nitrification Field: No Fields 1 Square Feet 1200 Linear Feet 400
No Lines 5 Trench Width 3' Max Trench Bottom Depth 36" Gravel Depth _____

☑ New System ☐ Repair System Type: I (II) III, IV, V, VI
System Description: CONV - D BOX
Repair System Description: PRESSURE CONV.
Maintenance Agreement Required: ☐ Yes ☑ No


☑ House/Mod. Home No. Bedrooms 3
☐ Mobile Home No. Bathrooms 2
☐ Business No. Employees _____
☐ Other _____
☐ Slab ☑ Crawl Space ☐ Basement w/plumbing ☐ Basement wo/plumbing

Water Supply:
☑ Individual
☐ Community
☐ Public

Comments: PLUMBING MUST BE SHALLOW - MAXIMUM 6" COVER OVER SEPTIC TANK - SLIGHTLY AGAINST SLOPE IP — NECESSARY FOR REPAIR SPACE

Comments:

INITIAL SITE SKETCH

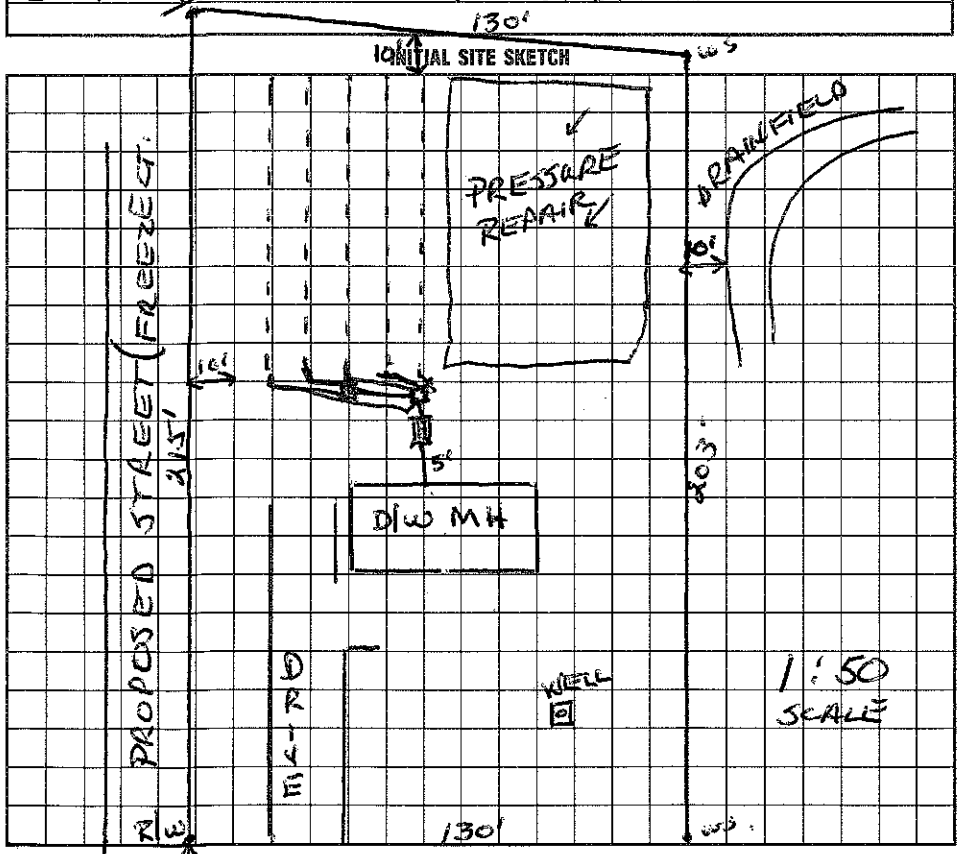

AS BUILT SKETCH

I understand that this permit can be suspended or revoked if any false information is supplied toward securing the permit/any unauthorized changes are made to the site/any unauthorized changes are made in the installation of the system. Improvement Permit is valid for 60 months from date of issuance.

Signed: _____ Installed by: Barry Seymour

Improvement Permit by: Wesley Sparks R.S. date 2/23/94 Certificate of Completion by: Wesley Sparks R.S. date 4/12/94

Existing System Inspection by: _____ date _____ Operation Permit by: _____ date _____

HEALTH DEPT. COPY: WHITE INSPECTION COPY (FINAL): GREEN OWNER COPY (FINAL): YELLOW INSPECTION COPY (INITIAL): PINK OWNER COPY (INITIAL): GOLD