IREDELL COUNTY HEALTH DEPARTMENT

Authorization to Construct

STATESVILLE 704-878-5305 MOORESVILLE 704-664-5281

IMPROVEMENT PERMIT / ~~CERTIFICATE OF COMPLETION~~ / OPERATION PERMIT / EXISTING SYSTEM INSPECTION

PROPERTY DESCRIPTION NO. 22131 DATE 2/21/96 TAX MAP NO. 4E 4A 5 Watershed: ☒ Yes ☒ No

OWNER OR CONTRACTOR Michael Parker PHONE: Business Home 588-9367

ADDRESS 131 Fawn Crossing Dr. Mooresville, NC. 28115 PIN# 4659-34-8797

LOCATION 115-21N TR Fawn Crossing Dr. to 5th. Jct on (L)

SUBDIVISION Fawn Crossing BLOCK / SECTION 1 LOT 5 LOT AREA ~1.7Ac SITE CLASS. PS DESIGN FLOW 360 L.T.A.R. .3

Septic Tank: 1000 Gallons; STB 714 Date 3/22/96

Pump Tank: _____ Gallons; PT _____ Date _____

Pump Make: _____ Model _____ Serial No. _____

Nitrification Field: No Fields 1 Square Feet 1200 Linear Feet 400

No Lines 3 Trench Width 36" Max Trench Bottom Depth 36" Gravel Depth 12"

☒ New System ☐ Repair System Type: I, II, III, IV, V, VI

System Description: Gravity Conventional

Repair System Description: Same

Maintenance Agreement Required: ☐ Yes ☐ No

☐ House/Mod. Home ☒ Mobile Home ☐ Business ☐ Other

No. Bedrooms 3 No. Bathrooms 2 No. Employees ____


☐ Slab ☒ Crawl Space ☐ Basement w/plumbing ☐ Basement wo/plumbing

Water Supply: ☒ Individual ☐ Community ☐ Public

Comments:

Comments:

INITIAL SITE SKETCH

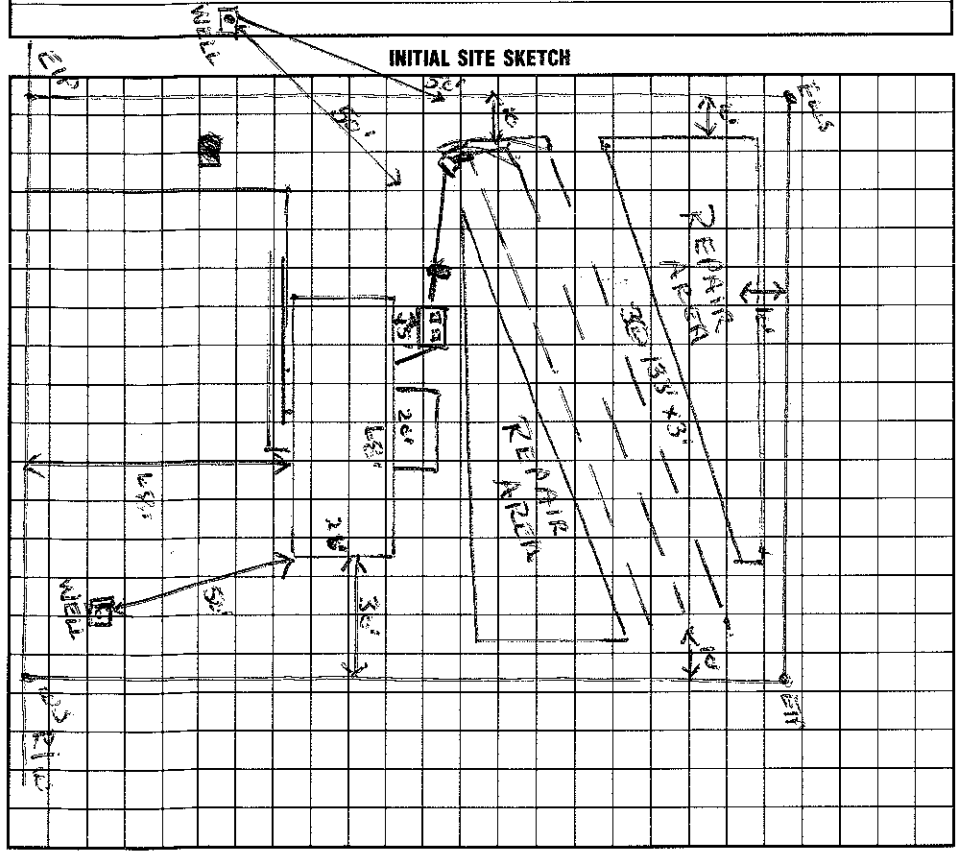

AS BUILT SKETCH

Same as initial site sketch

I understand that this permit can be suspended or revoked if any false information is supplied toward securing the permit/any unauthorized changes are made to the site/any unauthorized changes are made in the installation of the system.

Signed: Earl Parker

Improvement Permit by: Wesley Sparks RS date 2/21/96

Existing System Inspection by: Authorized Agent Wesley Sparks RS. date 2/21/96

Installed by: Dennis Gaither A1 Backhoe

Certificate of Completion by: _____ date _____

Operation Permit by: Brady Koerner EHSI date 5/15/96

HEALTH DEPT. COPY: WHITE INSPECTION COPY (FINAL): GREEN OWNER COPY (FINAL): YELLOW INSPECTION COPY (INITIAL): PINK OWNER COPY (INITIAL): GOLD