4659 36 1121

IREDELL COUNTY HEALTH DEPARTMENT

STATESVILLE 704-878-5305 MOORESVILLE 704-664-5281

IMPROVEMENT PERMIT / AUTHORIZATION TO CONSTRUCT / OPERATION PERMIT / EXISTING SYSTEM INSPECTION

PERMIT # N/A PIN # 4659 36 ~~1244~~ 1121 DATE 10/28/09

OWNER or APPLICANT BRENDA WILKIE PHONE: Business 704-883-7509 Home:

OWNER or APPLICANT ADDRESS 11626 CROWN VIEW CT. STATESVILLE, NC. 28625

LOCATION / DIRECTIONS 115 N TR WESTMORELAND RD. TR LITTLE DAISY RD. TO # 138 ON R

SUBDIVISION ~~FOX RUN~~ BLOCK / SECTION LOT # ~~48~~ LOT AREA ~4Ac DESIGN FLOW 360 LTAR .3

Septic Tank ① 1000 Gallons: STB 1017 Date 5/12/09
Pump Tank ~~FOR RUN~~ Gallons: PT 17 Date 5/10/08
Pump Make ② ZOELLER Model PES9M Serial #
Nitrification Field No Fields EXISTING 3 Linear Feet 150
Trench Width 9' Max. Trench Bottom Depth Gravel Depth 16"

☐ New System ☒ Repair ☐ Expansion System Type I II (III) IV V VI
System Description:
Repair System Description: NEW PUMP - GATEVALVE - WASHBOX
Maintenance Agreement Required ☐ YES ☒ NO
☐ GRAVITY ☒ PRESSURE

☒ Residence No. Bedrooms 3
☐ Business No. Persons
☐ Other No. Employees
☐ Slab ☐ Crawl Space
☒ Basement w/plumbing ☐ Basement w/o plumbing


Water Supply: ☒ Private ☐ Public ☐ Community

Comments / Conditions ① REPLACE BROKEN EXISTING ST WITH NEW 1000 GAL ST WITH FILTER ② INSTALL NEW PUMP, CONTROLS, AND OUTDOOR ALARM


Comments / Conditions 704-546-2780

Proposed Accessory Not to Scale

INITIAL SITE SKETCH

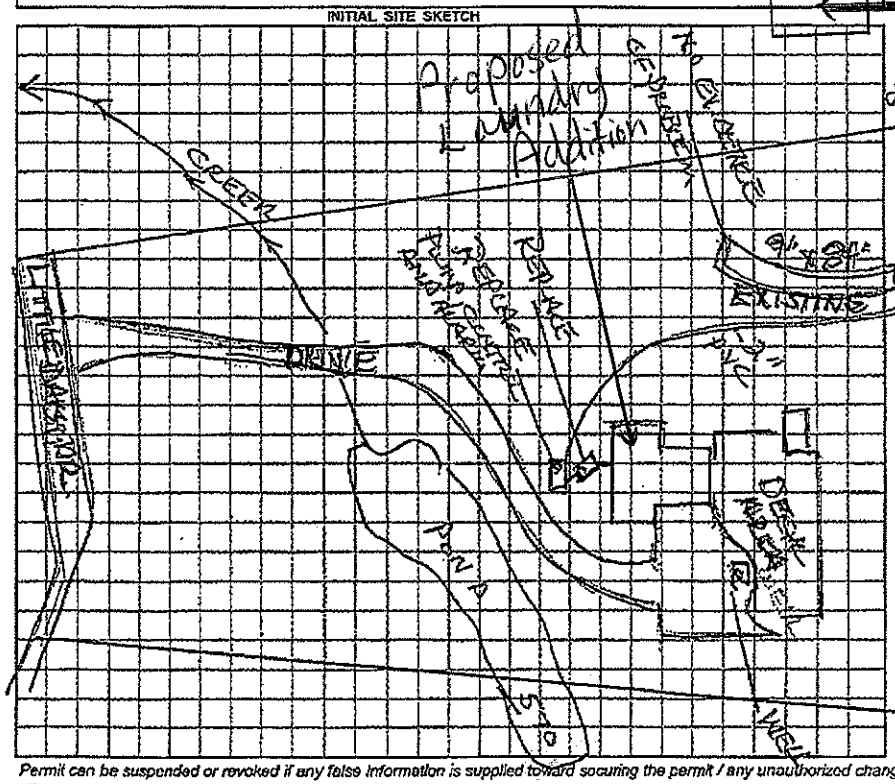

AS BUILT SKETCH

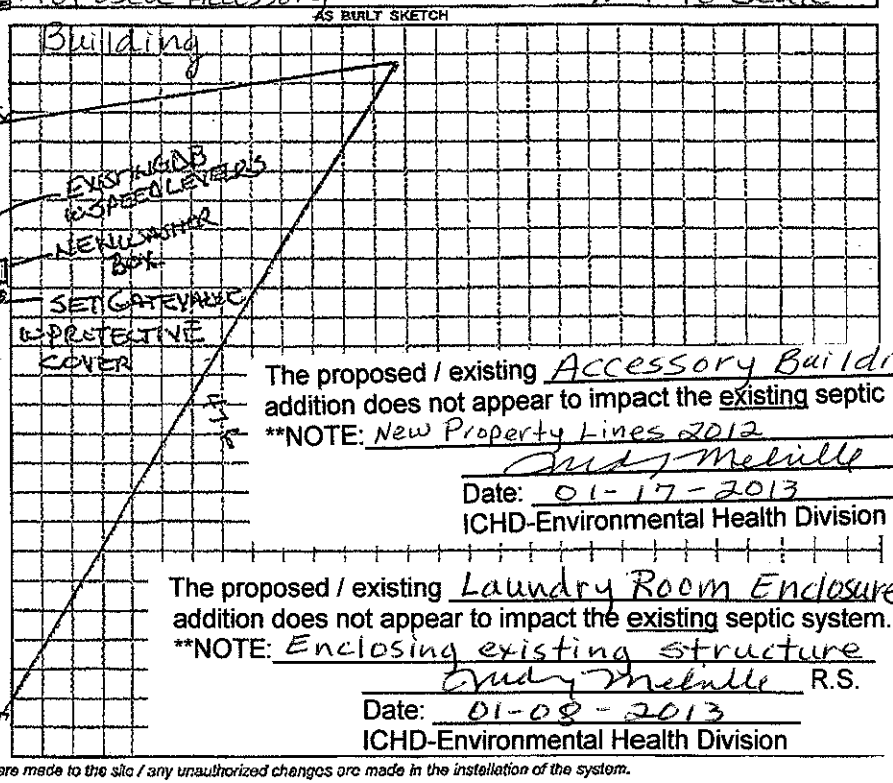

The proposed / existing Accessory Building addition does not appear to impact the existing septic system.
**NOTE: New Property Lines 2012
Andy Melville REHS
Date: 01-17-2013
ICHD-Environmental Health Division

The proposed / existing Laundry Room Enclosure addition does not appear to impact the existing septic system.
**NOTE: Enclosing existing structure
Andy Melville R.S.
Date: 01-08-2013
ICHD-Environmental Health Division

Permit can be suspended or revoked if any false information is supplied toward securing the permit / any unauthorized changes are made to the site / any unauthorized changes are made in the installation of the system.

☐ *IMPROVEMENT PERMIT w / plat valid without expiration.* ☐ *IMPROVEMENT PERMIT w / site plan valid for 60 mos.* ☐ *AUTHORIZATION TO CONSTRUCT valid for period equal to IMPROVEMENT PERMIT-not to exceed 60 mo.*

Owner / Applicant Signature: Craig Hogan Date 11-4-09
Improvement Permit by: Wesley Sparks REHS Date 10/28/09
Authorization to Construct by: Wesley Sparks REHS Date 10/28/09
YOU SHOULD CONTACT A LOCATOR SERVICE PRIOR TO ANY EXCAVATION.

Installed by: Tony Fryar
Operation Permit by: Wesley Sparks REHS Date: 11/6/09
Existing System Inspected by: Date:

WHITE COPY Environmental Health YELLOW COPY (Final) Owner / Applicant PINK COPY (Initial) Owner / Applicant