# IREDELL COUNTY HEALTH DEPARTMENT

STATESVILLE 704-878-5305 MOORESVILLE 704-664-5281

## IMPROVEMENT PERMIT / AUTHORIZATION TO CONSTRUCT / OPERATION PERMIT / EXISTING SYSTEM INSPECTION

PERMIT # N/A PIN # 4659 36 ~~1244~~ 1121 DATE 10/28/09

OWNER or APPLICANT BRENDA WILKIE PHONE: Business 704-883-7509 Home:

OWNER or APPLICANT ADDRESS 1626 CROWN VIEW CT. STATESVILLE, NC. 28625

LOCATION / DIRECTIONS I-77 N TO EXIT 138 ON R WESTMORELAND RD. TR LITTLE DAISY RD. TO # 138 ON R

SUBDIVISION ~~FOX RUN~~ BLOCK / SECTION LOT # 18 LOT AREA ~4AC DESIGN FLOW 360 L.T.A.R. .3

Septic Tank (1) 1000 Gallons: STB 1011 Date 5/10/09
Pump Tank EXISTING Gallons: PT 1M Date 5/10/08
Pump Make (2) ZOELLER Model PES1M Serial #
Nitrification Field No Fields EXISTING No Lines 3 Linear Feet 250
Trench Width 9' Max. Trench Bottom Depth Gravel Depth 16"

☐ New System ☒ Repair ☐ Expansion System Type I II (III) IV V VI
System Description:
Repair System Description: NEW PUMP - GATEVALVE - WASHER BOX
Maintenance Agreement Required ☐ YES ☒ NO
☐ GRAVITY ☒ PRESSURE


☒ Residence No. Bedrooms 3
☐ Business No. Persons
☐ Other No. Employees
☐ Slab ☐ Crawl Space
☒ Basement w/plumbing ☐ Basement w/o plumbing

Water Supply: ☒ Private ☐ Public ☐ Community


Comments / Conditions (1) REPLACE BROKEN EXISTING ST WITH NEW 1000GAL ST WITH FILTER (2) INSTALL NEW PUMP, CONTROLS, AND OUTDOOR ALARM

Comments / Conditions 704-546-2780

INITIAL SITE SKETCH

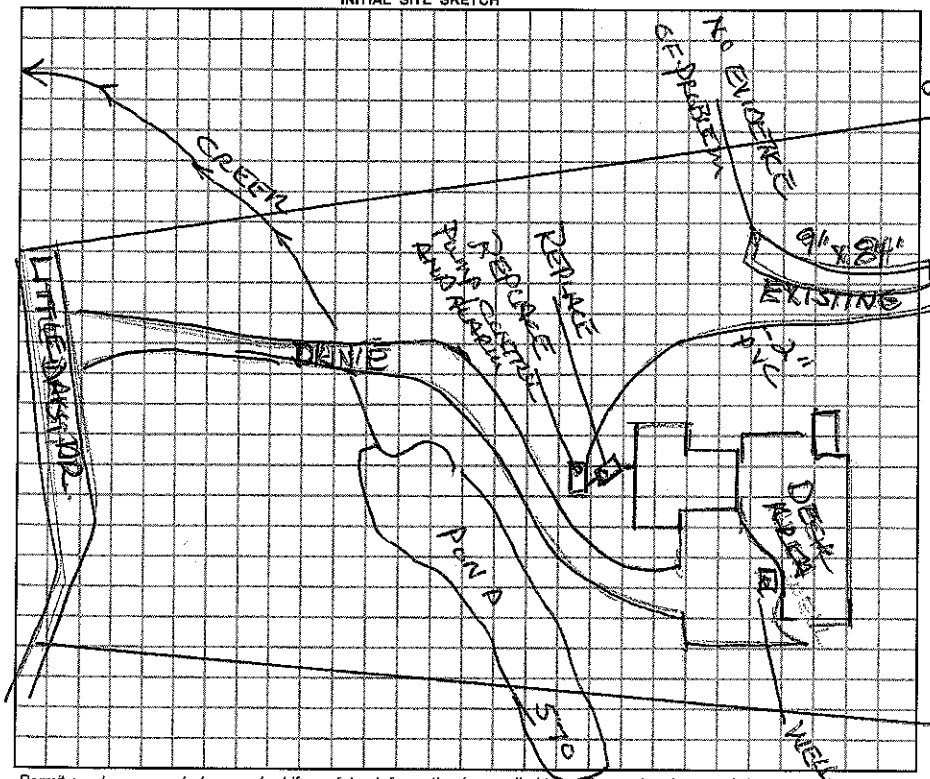


AS BUILT SKETCH

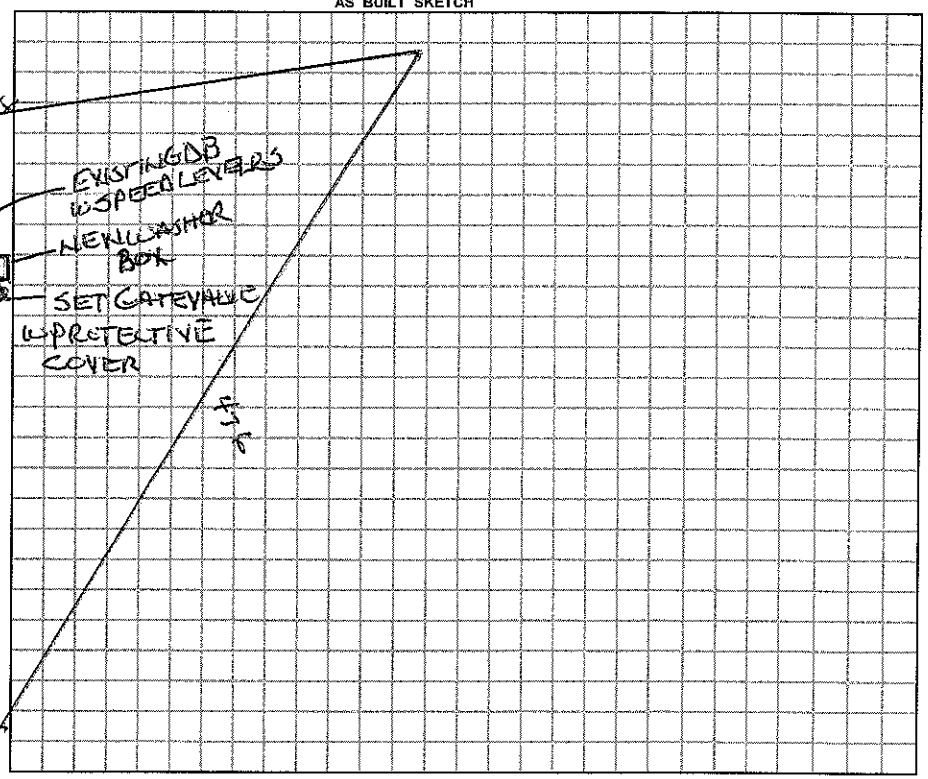


*Permit can be suspended or revoked if any false information is supplied toward securing the permit / any unauthorized changes are made to the site / any unauthorized changes are made in the installation of the system.*

☐ *IMPROVEMENT PERMIT w / plat valid without expiration.* ☐ *IMPROVEMENT PERMIT w / site plan valid for 60 mos.* ☐ *AUTHORIZATION TO CONSTRUCT valid for period equal to IMPROVEMENT PERMIT-not to exceed 60 mo.*

Owner / Applicant Signature: * Date 11-4-09

Improvement Permit by: Wesley Sparks REHS Date 10/28/09

Authorization to Construct by: Wesley Sparks REHS Date 10/28/09

Installed by: Tony Frye

Operation Permit by: Wesley Sparks REHS Date: 11/6/09

Existing System Inspected by: Date:

***YOU SHOULD CONTACT A LOCATOR SERVICE PRIOR TO ANY EXCAVATION.***

WHITE COPY Environmental Health YELLOW COPY (Final) Owner / Applicant PINK COPY (Initial) Owner / Applicant