IREDELL COUNTY HEALTH DEPARTMENT

Statesville Office (704) 878-5305 Mooresville Office (704) 660-3625 PERMIT # 190716

IMPROVEMENT PERMIT / AUTHORIZATION TO CONSTRUCT / OPERATION PERMIT / EXISTING SYSTEM

PIN # 4659364184

APPLICANT: Thomas & Deborah Plate APPLICANT ADDRESS: 100 Huntington Ridge Rd, Madison, AL 35757

SITE ADDRESS: 154 Little Daisy Rd. PHONE: 256 721 0975 ALT. PHONE: 256-929-3620

SITE DIRECTIONS: I-75, take exit 42, (R) on 115/21 to (L) on Westmoreland, (R) on Little Daisy, at bottom of hill on (R)

SUBDIVISION: Brian ~~Dale~~ Campe' SECTION: LOT # ~~4~~ 1 LOT AREA: 2.839 Acres DESIGN FLOW: 360 L.T.A.R.: .3


Septic Tank	1000 (gal)	STB	760	Date	2-26-14	☒ New System	☐ Repair	☐ Expansion	System Type: I II (III) IV V VI	☒ Residence	No. Bedrooms 3
Pump Tank	1000 (gal)	PT	363	Date	8-23-13	System Description: 25% Reduction Pump				☐ Business	No. Persons
Pump Make	ZOELLER Model	E165D		Serial #		Repair System Description: 25% Reduction Pump				☐ Other	No. Employees
# Nitrification Fields	1 # Lines	3		Linear Ft:	300	Maintenance Agreement Required:	☐ YES	☒ NO		☐ Slab	☐ Crawl Space
Trench Width	36" Max. Trench Bottom Depth	36"		Gravel Depth	n/a		☐ GRAVITY	☒ PRESSURE		☒ Basement w/plumbing	☐ Basement w/o plumbing

Water Supply: ☒ Private ☐ Public ☐ Community

Comments / Conditions: 13ft to side PL & ~31ft to PL. Tanks in some expansive clay 15ft from Deck posts to ST

Used Sch 80 1/2" taps on 2/26/14 Used EZ Flow for Drainfield Essentially as Drawn Checked tanks Supply line & Drainlines

INITIAL SITE SKETCH

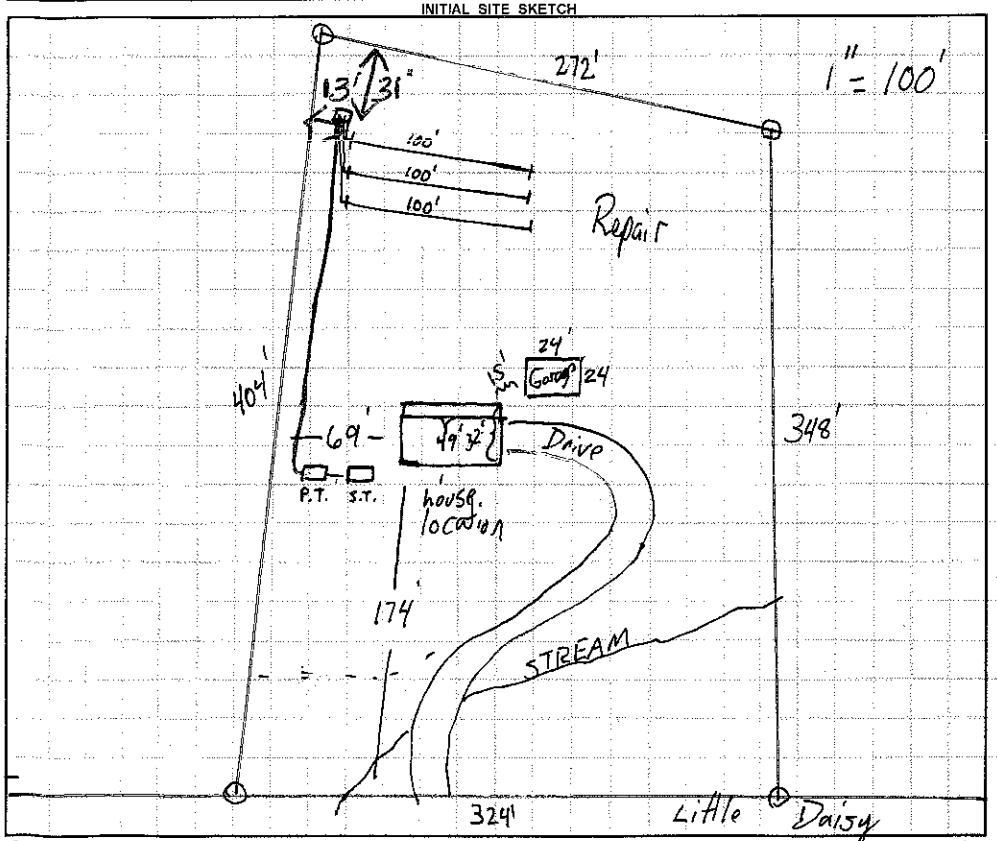

AS BUILT SKETCH

528606-9059

Permit can be suspended or revoked if any false information is supplied toward securing the permit / any unauthorized changes are made to the site / any unauthorized changes are made in the installation of the system. **CONTACT A LOCATOR SERVICE PRIOR TO ANY EXCAVATION**

☐ **IMPROVEMENT PERMIT** *with plat valid without expiration.* ☒ **IMPROVEMENT PERMIT** *with site plan valid for 60 mos.* ☐ **AUTHORIZATION TO CONSTRUCT** *valid for period equal to IMPROVEMENT PERMIT--not to exceed 60 mo.*

Owner / Applicant Signature: Date: 10-1-13 Installed by: Williams Grading #3854

IMPROVEMENT PERMIT by: Date: 10-3-13 OPERATION PERMIT by: Date: 7-23-14

AUTHORIZATION TO CONSTRUCT by: Date: 10-7-13 Existing System Inspected by: Date:

Health Dept. Copy - WHITE Applicant (Final Approval) - YELLOW Applicant (Conditional Approval) - PINK