IREDELL COUNTY HEALTH DEPARTMENT

STATESVILLE 704-878-5305 MOORESVILLE 704-664-5281

IMPROVEMENT PERMIT / CERTIFICATE OF COMPLETION / OPERATION PERMIT / EXISTING SYSTEM INSPECTION

PROPERTY DESCRIPTION NO. 17616 DATE 12/28/93 TAX MAP NO. 4E A 4 Pt of 5 Watershed: ☑ Yes ☐ No

OWNER OR CONTRACTOR KEITH CARROLL CONST. ~~PHONE: Business~~ 4659-30-6874 Home 664-1155

ADDRESS 795 FRENCH BELK RD. MT ULLA NC 28125

LOCATION WEST MORELAND RD, TR ON EQUESTRIAN DR. TR ON HORSESTABLE CT. TO CULDESAC, LOT ON (R)

SUBDIVISION LAURELWOOD BLOCK / SECTION _____ LOT 13 LOT AREA ~.47AC SITE CLASS. P DESIGN FLOW 360 L.T.A.R. .25

Septic Tank: 1000 Gallons; STB 353 Date 12/30/93
Pump Tank: _____ Gallons; PT _____ Date _____
Pump Make: _____ Model _____ Serial No. _____
Nitrification Field: No Fields 1 Square Feet 1440 Linear Feet 240 X
No Lines 3 Trench Width 2' Max Trench Bottom Depth 30" Gravel Depth 6" SAND

☑ New System ☐ Repair System Type: I, II, (III), IV, V, VI
System Description: PPBS 16"
Repair System Description: PRES. PANEL
Maintenance Agreement Required: ☐ Yes ☑ No

☑ House/Mod. Home No. Bedrooms 3
☐ Mobile Home No. Bathrooms 2
☐ Business No. Employees ____
☐ Other _____


☐ Slab ☑ Crawl Space ☐ Basement w/plumbing ☐ Basement wo/plumbing

Water Supply:
☐ Individual
☑ Community
☐ Public

Comments: X 16 PREFAB. PANEL BLOCK DRAINFIELD. PLUMBING MUST BE AT GROUND LEVEL DUE TO MAX. TRENCH DEPTH 30"

Comments:

INITIAL SITE SKETCH

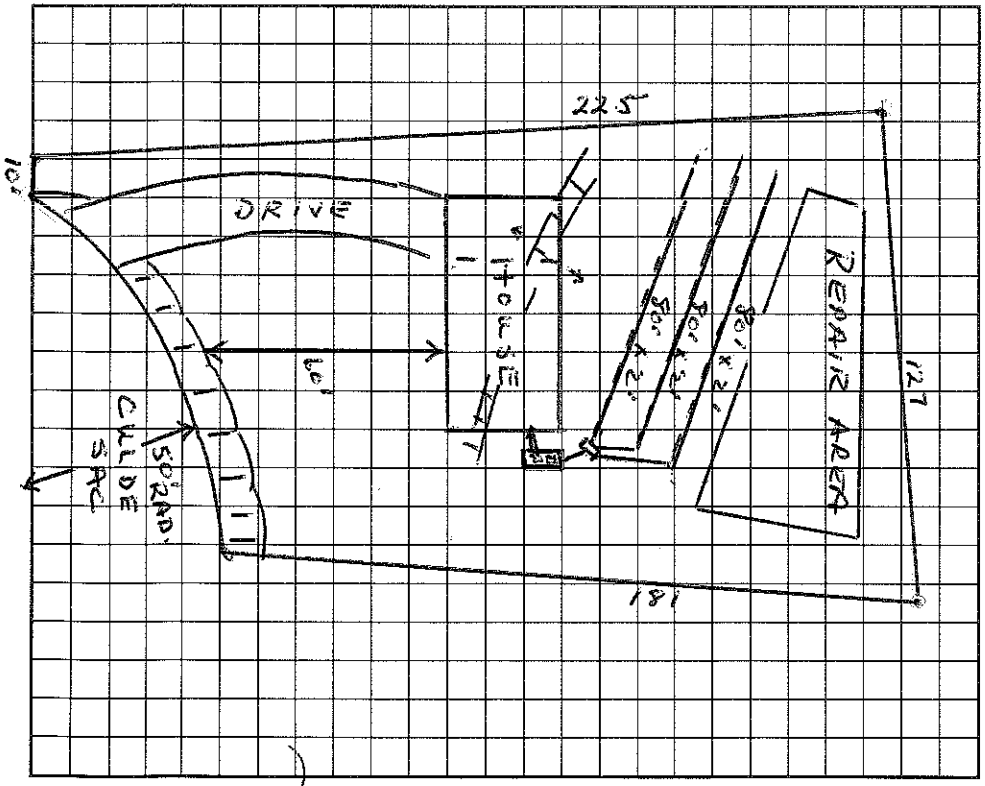

AS BUILT SKETCH

Installed as shown.

I understand that this permit can be suspended or revoked if any false information is supplied toward securing the permit/any unauthorized changes are made to the site/any unauthorized changes are made in the installation of the system. Improvement Permit is valid for 60 months from date of issuance.

Signed: _____

Improvement Permit by: W. Wesley Sparks R.S. date 12/28/93

Existing System Inspection by: _____ date _____

Installed by: F J Ervin

Certificate of Completion by: Wesley Sparks R.S. date 3/15/94

Operation Permit by: _____ date _____

HEALTH DEPT. COPY: WHITE INSPECTION COPY (FINAL): GREEN OWNER COPY (FINAL): YELLOW INSPECTION COPY (INITIAL): PINK OWNER COPY (INITIAL): GOLD