IREDELL COUNTY HEALTH DEPARTMENT

STATESVILLE 704-878-5305 MOORESVILLE 704-664-5281

IMPROVEMENT PERMIT / CERTIFICATE OF COMPLETION / OPERATION PERMIT / EXISTING SYSTEM INSPECTION

PROPERTY DESCRIPTION NO. 18259 DATE 4/22/94 TAX MAP NO. 4F A 4 pt of Watershed: ☐ Yes ☑ No

OWNER OR CONTRACTOR Keith Carroll Const. PHONE: Business 664-1155 ~~Home~~ 4659-36-8685

ADDRESS 795 French Back Rd. Mt Ulla NC. 28125

LOCATION WESTMORELAND, TR EQUESTRIAN DR. ON (R) 1ST Lot PAST HORSESTABLE CT.

SUBDIVISION LAURELWOOD BLOCK / SECTION 1 LOT 11 LOT AREA ~ 29000FT² SITE CLASS. P DESIGN FLOW 360 L.T.A.R. .25

Septic Tank: 1000 Gallons; STB 794 Date 7/6/94
Pump Tank: _____ Gallons; PT _____ Date _____
Pump Make: _____ Model _____ Serial No. _____
Nitrification Field: No Fields 1 Square Feet 1440 Linear Feet 240 *
No Lines 4 Trench Width 2' Max Trench Bottom Depth 34" Gravel Depth 6" SAND

☑ New System ☐ Repair System Type: I, II, III, IV, V, VI
System Description: 16" PANEL
Repair System Description: _____
Maintenance Agreement Required: ☐ Yes ☐ No


☑ House/Mod. Home No. Bedrooms 3
☐ Mobile Home No. Bathrooms 2
☐ Business No. Employees ____
☐ Other _____
☐ Slab ☐ Crawl Space ☐ Basement w/plumbing ☐ Basement wo/plumbing

Water Supply:
☐ Individual
☑ Community
☐ Public


Comments: Lines are slightly angle shape from SIT; Keep Septic Tank shallow

Comments:

INITIAL SITE SKETCH

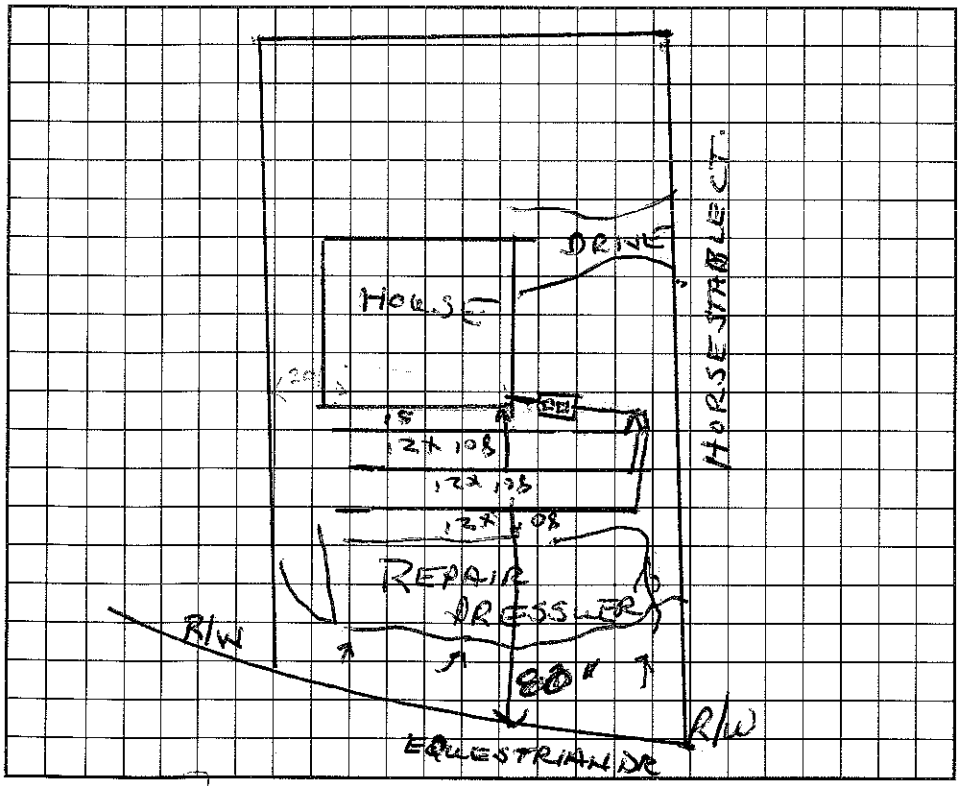

AS BUILT SKETCH

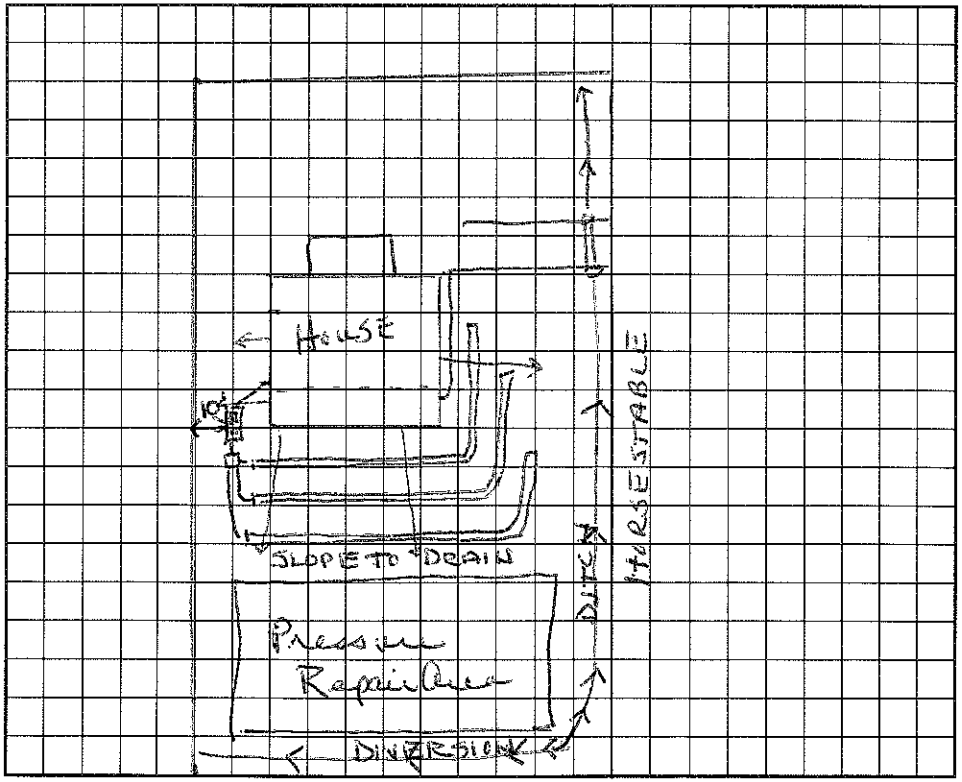

I understand that this permit can be suspended or revoked if any false information is supplied toward securing the permit/any unauthorized changes are made to the site/any unauthorized changes are made in the installation of the system. Improvement Permit is valid for 60 months from date of issuance.

Signed: _____

Improvement Permit by: Wesley Sparks R.S. date 4/22/94

Existing System Inspection by: _____ date _____

Installed by: FJ ERVIN

Certificate of Completion by: Wesley Sparks R.S. date 8/30/94

Operation Permit by: _____ date _____

HEALTH DEPT. COPY: WHITE INSPECTION COPY (FINAL): GREEN OWNER COPY (FINAL): YELLOW INSPECTION COPY (INITIAL): PINK OWNER COPY (INITIAL): GOLD