IREDELL COUNTY HEALTH DEPARTMENT

STATESVILLE 704-878-5305 MOORESVILLE 704-664-5281

IMPROVEMENT PERMIT / CERTIFICATE OF COMPLETION / OPERATION PERMIT / EXISTING SYSTEM INSPECTION

PROPERTY DESCRIPTION NO. 18261 DATE 8/24/94 TAX MAP NO. 4E A 4 Pt of F Watershed: ☐ Yes ☑ No

OWNER OR CONTRACTOR Keith Carroll Const. PHONE: Business 664-1155 ~~Home~~ 4659-36-8910

ADDRESS 795 French Belk Rd Mt Ulla NC

LOCATION Equestrian Dr. (R) off Westmoreland - 1st lot on (R)

SUBDIVISION Lauralwood BLOCK / SECTION ____ LOT 15 LOT AREA 20,000 FT² SITE CLASS. P DESIGN FLOW 360 L.T.A.R. .25

Septic Tank: 1000 Gallons; STB 744 Bellaire Date 11-28-94

Pump Tank: ____ Gallons; PT ____ Date ____

Pump Make: ____ Model ____ Serial No. ____

Nitrification Field: No Fields 1 Square Feet 1356 Linear Feet ~~x~~ 240

No Lines 4 Trench Width 24" Max Trench Bottom Depth 32" Gravel Depth 6" SAND

☑ New System ☐ Repair System Type: I, II, (III), IV, V, VI

System Description: GRAVITY - PANEL

Repair System Description: SAME

Maintenance Agreement Required: ☐ Yes ☑ No

☑ House/Mod. Home No. Bedrooms 3

☐ Mobile Home No. Bathrooms 1

☐ Business No. Employees ____

☐ Other ____

☐ Slab ☑ Crawl Space ☐ Basement w/plumbing ☐ Basement wo/plumbing


Water Supply:
☐ Individual
☑ Community
☐ Public

Comments:
~~x~~ 16" PPBS


Plumbing must be shallow - Tank flush with ground surface

Comments:
Beginning 2 upper laterals deep but shallows out toward end.

INITIAL SITE SKETCH

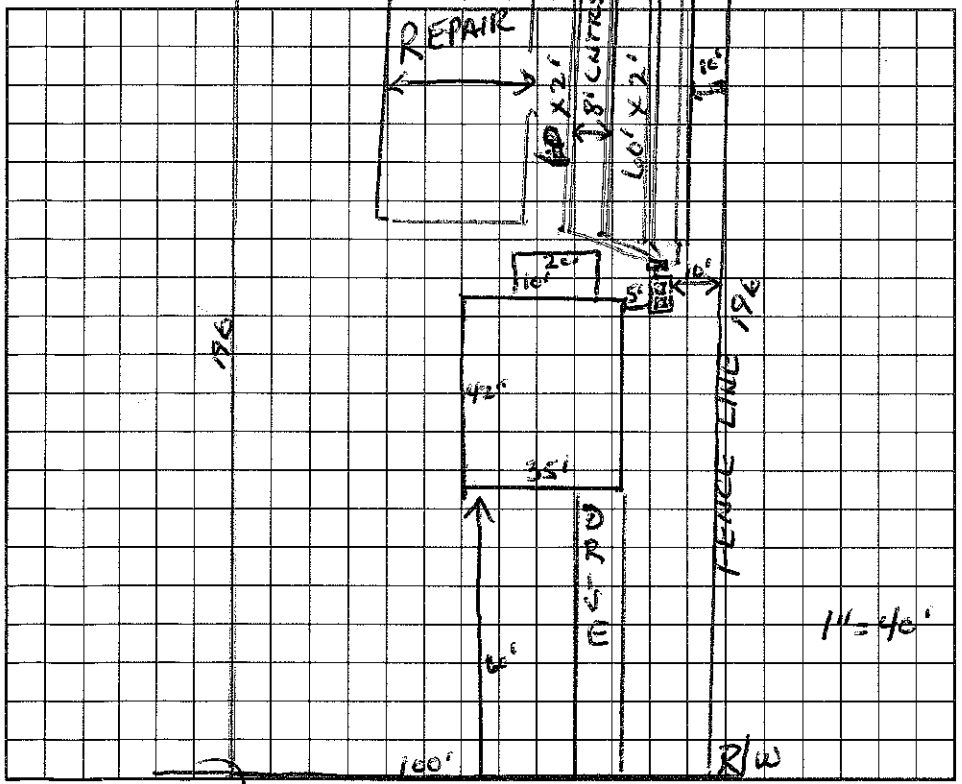

AS BUILT SKETCH

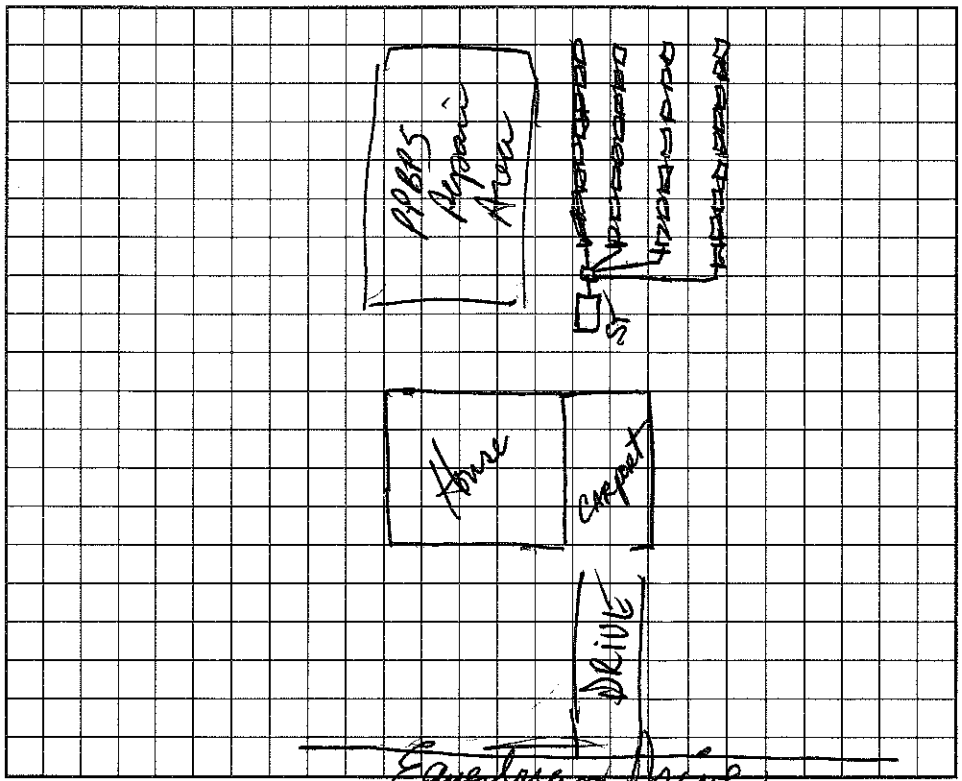

I understand that this permit can be suspended or revoked if any false information is supplied toward securing the permit/any unauthorized changes are made to the site/any unauthorized changes are made in the installation of the system. Improvement Permit is valid for 60 months from date of issuance.

Signed: ~~x~~ Keith Carroll EQUESTRIAN DR.

Improvement Permit by: Lindsey Partners date 8/24/94

Existing System Inspection by: ____ date ____

Installed by: J Green

Certificate of Completion by: ____ date ____

Operation Permit by: D E Hunsucker RS date 1-24-95

HEALTH DEPT. COPY: WHITE INSPECTION COPY (FINAL): GREEN OWNER COPY (FINAL): YELLOW INSPECTION COPY (INITIAL): PINK OWNER COPY (INITIAL): GOLD