# IREDELL COUNTY HEALTH DEPARTMENT

STATESVILLE 704-878-5305 MOORESVILLE 704-664-5281

## IMPROVEMENT PERMIT / CERTIFICATE OF COMPLETION / OPERATION PERMIT / EXISTING SYSTEM INSPECTION

PROPERTY DESCRIPTION NO. 19930 DATE 12/28/94 TAX MAP NO. 4E 5 A 10 Watershed: ☐ Yes ☒ No

OWNER OR CONTRACTOR Keith Carroll Const. ~~PHONE: Business~~ 4659-36-9516 Home 664-1155

ADDRESS PO Box 431 Mt. Mourne, NC. 28123

LOCATION Laurelwood - Equestrian Dr.

SUBDIVISION Laurelwood BLOCK / SECTION ____ LOT 10 LOT AREA ~ 19,854 SITE CLASS. P DESIGN FLOW 360 L.T.A.R. .3

Septic Tank: 1000 Gallons; STB 794 Date 4/13/95

Pump Tank: ____ Gallons; PT ____ Date ____

Pump Make: ____ Model ____ Serial No. ____

Nitrification Field: No Fields 1 Square Feet 1200 Linear Feet 210 *

No Lines 3 Trench Width 24" Max Trench Bottom Depth 36" Gravel Depth 6" STONE

☒ New System ☐ Repair System Type: I, II, III, IV, V, VI

System Description: Gravity Pond

Repair System Description: ____

Maintenance Agreement Required: ☐ Yes ☒ No

☒ House/Mod. Home No. Bedrooms 3

☐ Mobile Home No. Bathrooms 2

☐ Business No. Employees ____

☐ Other ____


☐ Slab ☒ Crawl Space ☐ Basement w/plumbing ☐ Basement wo/plumbing

Water Supply:
☐ Individual
☒ Community
☐ Public

Comments: * 16" Panel Block - Gravity

Comments: Installed as shown on Imp. Permit

INITIAL SITE SKETCH

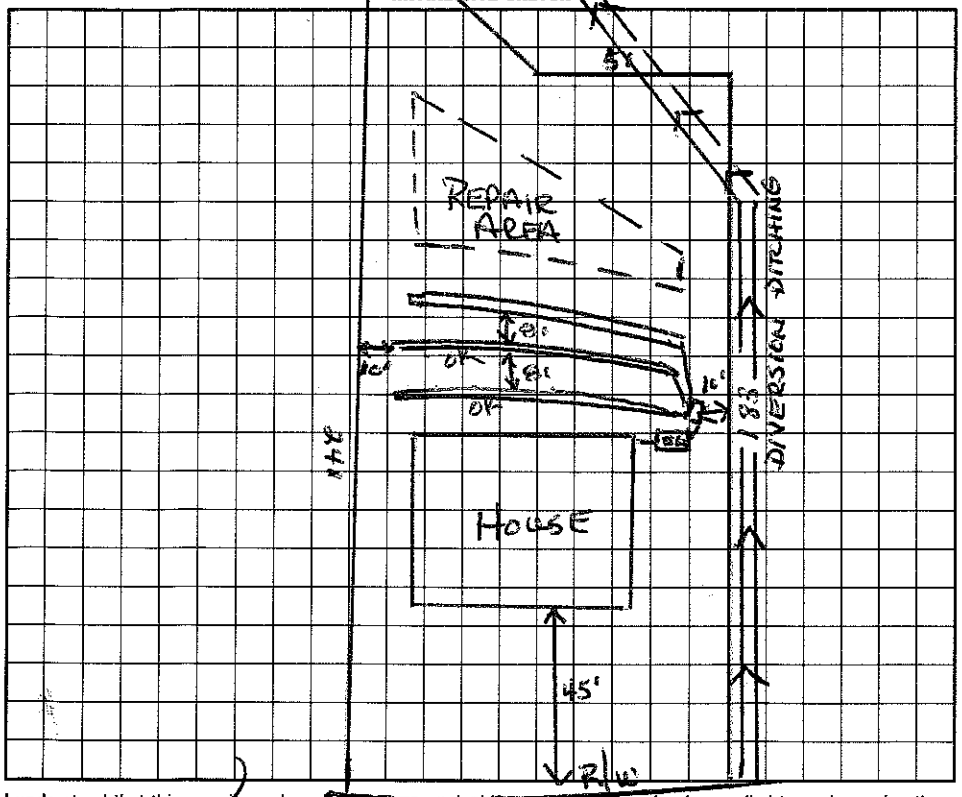


AS BUILT SKETCH

I understand that this permit can be suspended or revoked if any false information is supplied toward securing the permit/any unauthorized changes are made to the site/any unauthorized changes are made in the installation of the system. Improvement Permit is valid for 60 months from date of issuance. EQUESTRIAN DR.

Signed: X Keith Carroll

Improvement Permit by: Wesley Sparks RS. date 12/29/94

Existing System Inspection by: ____ date ____

Installed by: F J Ervin

Certificate of Completion by: Wesley Sparks RS. date 6/23/95

Operation Permit by: ____ date ____

HEALTH DEPT. COPY: WHITE INSPECTION COPY (FINAL): GREEN OWNER COPY (FINAL): YELLOW INSPECTION COPY (INITIAL): PINK OWNER COPY (INITIAL): GOLD