IREDELL COUNTY HEALTH DEPARTMENT

Statesville Phone TR 3-7271 Mooresville Phone NO 3-1271

PERMIT TO INSTALL SEPTIC TANK

Permit No. 36 Permit Date 3-28- 1972

Owner Cransill Address [redacted] Shepherd Comm.

Installed By Raymond Adams Address [redacted] Alexander Co.

Location of Property 115 + US 21 N to Cardinal acres


Lot 12

Tank		Capacity		Length of Lines		Fixtures	
Block	( )	1000	(✓)	225'	( )	No. of Baths	( )
Precast	(✓)	1250	( )	250'	( )	Dishwasher	( )
		1500	( )	Other 110		Garbage Grdr.	( )
		Other				Other	

NOTIFY HEALTH DEPARTMENT AT LEAST EIGHT HOURS BEFORE TANK IS TO BE INSPECTED.

Final Inspection 3-28- 1972 Approved (✓) Disapproved ( )

Remarks Central Water System

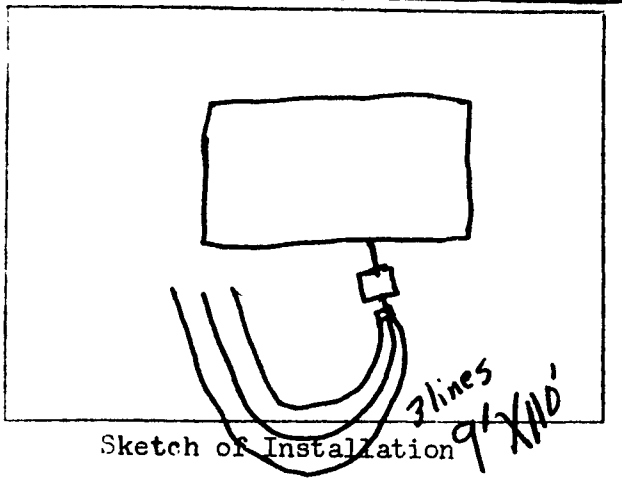

Sketch of Installation

J. C. Moore

Sanitarian