IREDELL COUNTY HEALTH DEPARTMENT

Statesville Phone TR 3-7271 Mooresville Phone NO 3-1271

PERMIT TO INSTALL SEPTIC TANK

Permit No. 118 Permit Date 6-29- 1972

Owner Cranfield Address Statesville

Installed By Adams Address Hiddenite


Location of Property Cardinal Acres off us 21 N Lot 13

Tank		Capacity		Length of Lines		Fixtures	
Block	( )	1000	(✓)	225'	( )	No. of Baths	(2)
Precast	(✓)	1250	( )	250'	( )	Dishwasher	no
		1500	( )	Other 330		Garbage Grdr.	(✓) no
		Other				Other	

NOTIFY HEALTH DEPARTMENT AT LEAST EIGHT HOURS BEFORE TANK IS TO BE INSPECTED.

Final Inspection 6-29-1972 Approved ( ) Disapproved ( )

Remarks

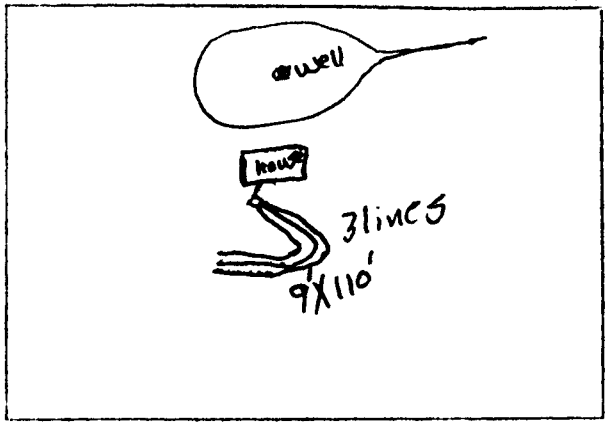

Sketch of Installation

J. C. Moore
Sanitarian