4659372309

IREDELL COUNTY HEALTH DEPARTMENT

STATESVILLE 704-878-5305 MOORESVILLE 704-664-5281

IMPROVEMENT PERMIT / CERTIFICATE OF COMPLETION / OPERATION PERMIT / EXISTING SYSTEM INSPECTION

PROPERTY DESCRIPTION NO. REPAIR DATE 5/16/97 TAX MAP NO. REPAIR Watershed: ☐ Yes ☒ No

OWNER OR CONTRACTOR TERRY OVERCASH PHONE: Business _____ Home 474-2237

ADDRESS # 153 WESTMORELAND MOORESVILLE, NC 28115

LOCATION 21/115 N / - TR WESTMORELAND # 153 WESTMORELAND RD

SUBDIVISION — BLOCK / SECTION — LOT — LOT AREA — SITE CLASS. 05 DESIGN FLOW 360 GPD L.T.A.R. —

Septic Tank: 1000 Gallons; STB _____ Date _____

Pump Tank: _____ Gallons; PT _____ Date _____

Pump Make: _____ Model _____ Serial No. _____

Nitrification Field: No Fields 1 Square Feet 450 Linear Feet 150

No Lines 3 @ 50' Trench Width 9" Max Trench Bottom Depth AS NEEDED Gravel Depth N/A

☒ New System ☒ Repair System Type: I, II, (III), IV, V, VI

System Description: _____

Repair System Description: GRAVITY CHAMBERED BED

Maintenance Agreement Required: ☐ Yes ☒ No

☒ House/Mod. Home No. Bedrooms 3

☐ Mobile Home No. Bathrooms 2

☐ Business No. Employees ____

☐ Other _____


☐ Slab ☒ Crawl Space ☐ Basement w/plumbing ☐ Basement wo/plumbing

Water Supply: ☐ Individual ☒ Community ☐ Public


Comments:

Comments:

INITIAL SITE SKETCH

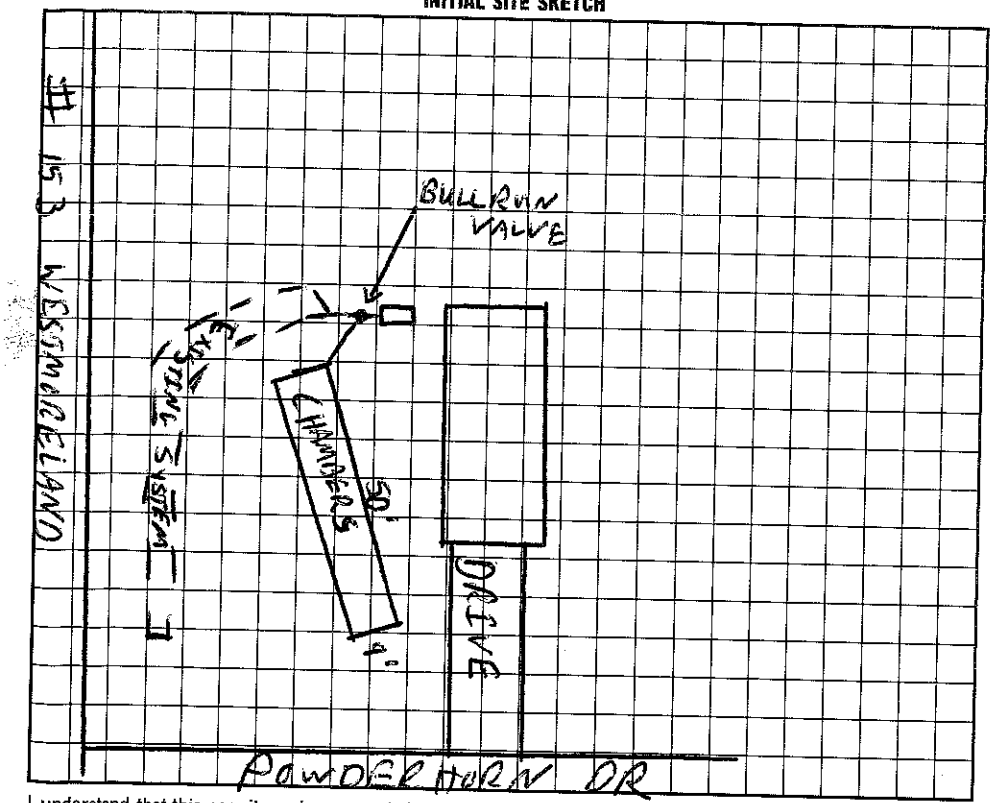

AS BUILT SKETCH

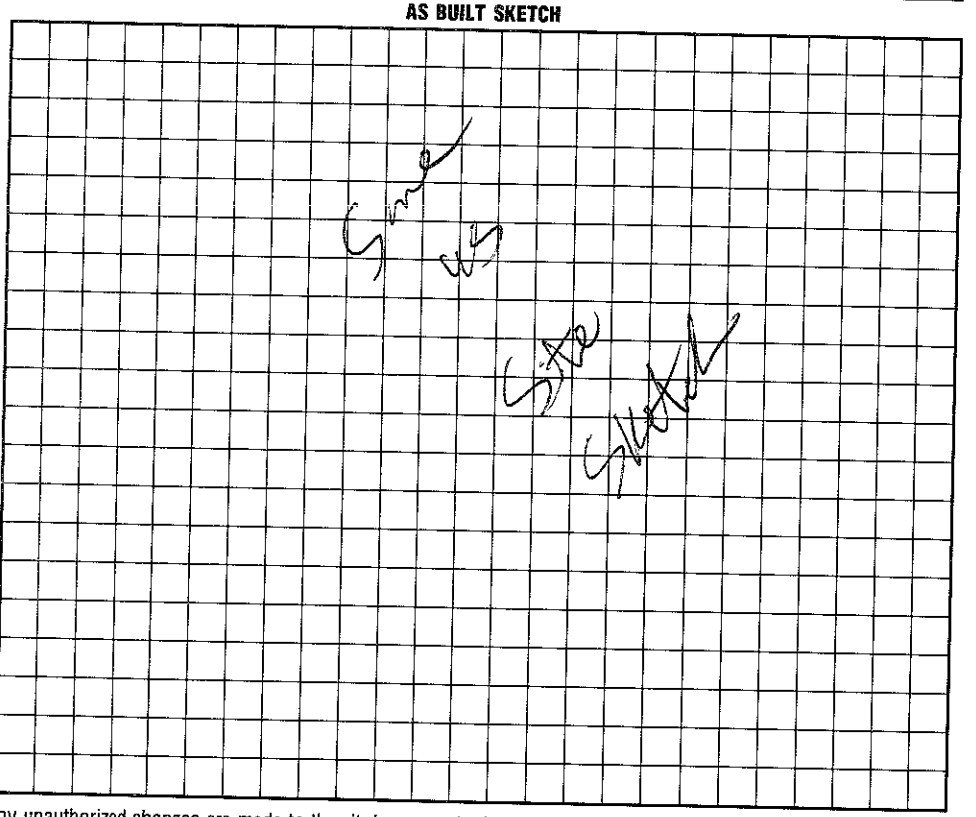

I understand that this permit can be suspended or revoked if any false information is supplied toward securing the permit/any unauthorized changes are made to the site/any unauthorized changes are made in the installation of the system. Improvement Permit is valid for 60 months from date of issuance.

Signed: Terry M. Overcash

Improvement Permit by: C. Ray Thomas date 5/16/97

Authorization to ~~Existing System Inspection by~~: C. Ray Thomas date 5/16/97

Installed by: LARRY BEAM

Certificate of Completion by: _____ date _____

Operation Permit by: C. Ray Thomas date 6/26/97

HEALTH DEPT. COPY: WHITE INSPECTION COPY (FINAL): GREEN OWNER COPY (FINAL): YELLOW INSPECTION COPY (INITIAL): PINK OWNER COPY (INITIAL): GOLD