IREDELL COUNTY HEALTH DEPARTMENT

Statesville Phone TR 3-7271 Mooresville Phone NO 3-1271

PERMIT TO INSTALL SEPTIC TANK

Permit No. 178 Permit Date 12 - 30 - 1971

Owner Harvey Cranfill Address Statesville nc

Installed By Raymond Adams Address Hiddenite NC

Location of Property Hwy 21 South. to Road # 2390

Brick House on Left Lot # 6


Water from Community Water Supply

Tank		Capacity		Length of Lines		Fixtures	
Block	( )	1000	(✓)	225'	( )	No. of Baths	(2)
Precast	(✓)	1250	( )	250'	( )	Dishwasher	( )
		1500	( )	Other 900 sq ft		Garbage Grdr.	( )
		Other				Other	

NOTIFY HEALTH DEPARTMENT AT LEAST EIGHT HOURS BEFORE TANK IS TO BE INSPECTED.

Final Inspection 12-30 1971 Approved (✓) Disapproved ( )

Remarks

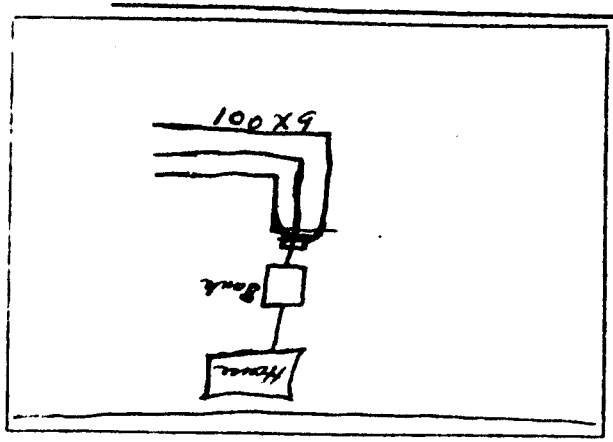

Sketch of Installation

E. G. Stevenson

Sanitarian