IREDELL COUNTY HEALTH DEPARTMENT

Statesville Phone TR 3-7271 Mooresville Phone NO 3-1271

PERMIT TO INSTALL SEPTIC TANK

Permit No. 179 Permit Date 12 - 31 - 1971

Owner Harvey Cranfield Address

Installed By Raymond Adams Address


Location of Property Rd # 2390 below Trantham, 1st rd North of Methodist cemetery (left) New house on left Lot #7

Tank		Capacity		Length of Lines		Fixtures	
Block	( )	1000	( )	225'	( )	No. of Baths	(2)
Precast	(✓)	1250	( )	250'	( )	Dishwasher	( )
		1500	( )	Other 900 sq'		Garbage Grdr.	( )
		Other				Other	

NOTIFY HEALTH DEPARTMENT AT LEAST EIGHT HOURS BEFORE TANK IS TO BE INSPECTED.

Final Inspection 12-31-1971 Approved (✓) Disapproved ( )

Remarks Community water

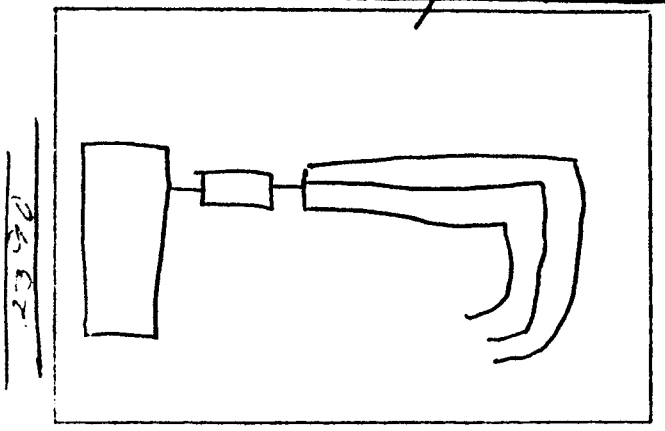

Sketch of Installation

Chas S. Hall

Sanitarian