IREDELL COUNTY HEALTH DEPARTMENT

STATESVILLE 704-878-5305 MOORESVILLE 704-664-5281

IMPROVEMENT PERMIT / CERTIFICATE OF COMPLETION / OPERATION PERMIT / EXISTING SYSTEM INSPECTION

PROPERTY DESCRIPTION NO. 17614 DATE 12/29/93 TAX MAP NO. 4E-A-4 Watershed: ☒ Yes ☐ No

OWNER OR CONTRACTOR KEITH CARROLL CONST. PHONE: Business 664-1155 ~~Home~~ 4659-37-9192

ADDRESS 795 FRENCH BELK RD. MT ULLA, NC. 28125

LOCATION WESTMORELAND RD, TR ON EQUESTRIAN DRIVE, TO THE 2ND LOT ON (L)

SUBDIVISION LAURELWOOD BLOCK / SECTION ____ LOT 2 LOT AREA ~.45AC SITE CLASS. P DESIGN FLOW 360 L.T.A.R. .2-.25

Septic Tank: 1000 Gallons; STB 794 Dettinger Date 3-11-94

Pump Tank: ____ Gallons; PT ____ Date ____

Pump Make: ____ Model ____ Serial No. ____

Nitrification Field: No Fields 1 Square Feet 1440 Linear Feet ~~X~~ 240

No Lines 3 Trench Width 2' Max Trench Bottom Depth 30" Gravel Depth 6" SAND

☒ New System ☐ Repair System Type: I, II, (III), IV, V, VI

System Description: PPBS - DIST BOX

Repair System Description: SAME

Maintenance Agreement Required: ☐ Yes ☒ No

☒ House/Mod. Home No. Bedrooms 3

☐ Mobile Home No. Bathrooms 2

☐ Business No. Employees ____

☐ Other ____


☐ Slab ☒ Crawl Space ☐ Basement w/plumbing ☐ Basement wo/plumbing

Water Supply: ☐ Individual ☒ Community ☐ Public

Comments: ~~X~~ 16" PREFAB. PANEL BLOCKS
MAXIMUM TRENCH DEPTH 30" - FOLLOW CONTOURS CLOSELY.

Comments:

INITIAL SITE SKETCH

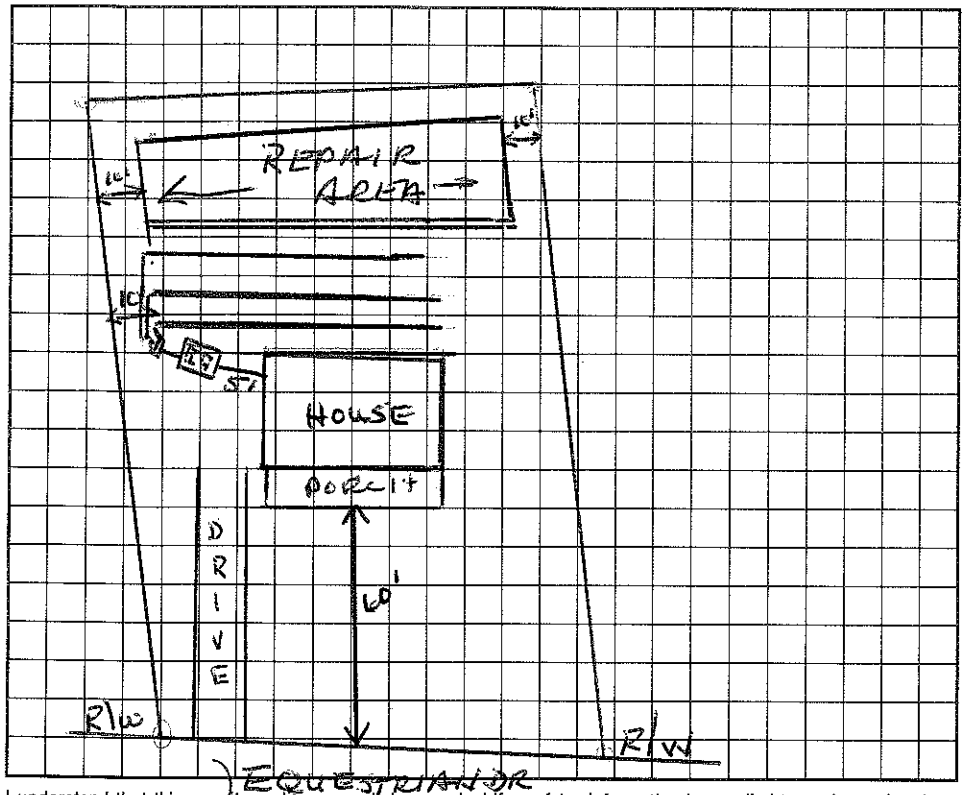

AS BUILT SKETCH

Substantially as initial shown on sketch

I understand that this permit can be suspended or revoked if any false information is supplied toward securing the permit/any unauthorized changes are made to the site/any unauthorized changes are made in the installation of the system. Improvement Permit is valid for 60 months from date of issuance.

Signed: [signature]

Improvement Permit by: Wesley Sparks RS. date 12/29/93

Existing System Inspection by: ____ date ____

Installed by: J J Ervin

Certificate of Completion by: ____ date ____

Operation Permit by: [signature] date ____

HEALTH DEPT. COPY: WHITE INSPECTION COPY (FINAL): GREEN OWNER COPY (FINAL): YELLOW INSPECTION COPY (INITIAL): PINK OWNER COPY (INITIAL): GOLD