IREDELL COUNTY HEALTH DEPARTMENT

STATESVILLE 704-878-5305 MOORESVILLE 704-664-5281

IMPROVEMENT PERMIT / CERTIFICATE OF COMPLETION / OPERATION PERMIT / EXISTING SYSTEM INSPECTION

PROPERTY DESCRIPTION NO. 17613 DATE 12/28/93 TAX MAP NO. 4E A 4 Watershed: ☑ Yes ☐ No

OWNER OR CONTRACTOR KEITH CARROLL CONST. ~~PHONE: Business~~ 4659-37-9264 Home 664-1155

ADDRESS 795 FRENCH BELK RD. MT ULLA NC. 28125

LOCATION WESTMORELAND RD. TR ON EQUESTRIAN DR. TO 1ST LOT ON (L)

SUBDIVISION LAURELWOOD BLOCK / SECTION _____ LOT 1 LOT AREA ~.45AC SITE CLASS. P DESIGN FLOW 360 L.T.A.R. .25-.3

Septic Tank: 1000 Gallons; STB 794 Date 11/19/94
Pump Tank: _____ Gallons; PT _____ Date _____
Pump Make: _____ Model _____ Serial No. _____
Nitrification Field: No Fields 1 Square Feet 1440 Linear Feet ~240
No Lines 3 Trench Width 2' Max Trench Bottom Depth 28" Gravel Depth 6" SAND

☑ New System ☐ Repair System Type: I, II, (III), IV, V, VI
System Description: 16" PPBS - DISTBOX
Repair System Description: SAME
Maintenance Agreement Required: ☐ Yes ☑ No

☑ House/Mod. Home No. Bedrooms 3
☐ Mobile Home No. Bathrooms 2
☐ Business No. Employees ____
☐ Other _____


☐ Slab ☑ Crawl Space ☐ Basement w/plumbing ☐ Basement wo/plumbing

Water Supply:
☐ Individual
☑ Community
☐ Public

Comments: 16" PREFAB. PANELS
MAX. TRENCH DEPTH OF 30-32"

Comments:
installed as shown.

INITIAL SITE SKETCH

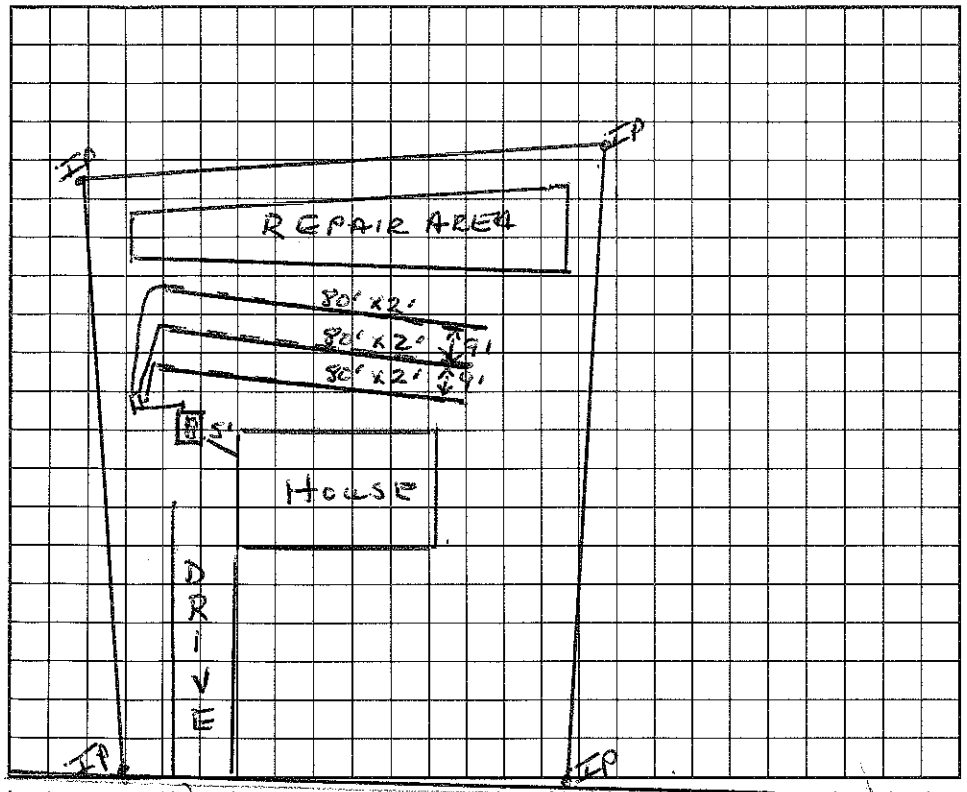

AS BUILT SKETCH

I understand that this permit can be suspended or revoked if any false information is supplied toward securing the permit/any unauthorized changes are made to the site/any unauthorized changes are made in the installation of the system. Improvement Permit is valid for 60 months from date of issuance.

Signed: _____ EQUESTRIAN ROAD

Improvement Permit by: Wesley Sparks RS. date 12/28/93

Existing System Inspection by: _____ date _____

Installed by: FJ Ervin

Certificate of Completion by: Wesley Sparks RS. date 2/21/95

Operation Permit by: _____ date _____

HEALTH DEPT. COPY: WHITE INSPECTION COPY (FINAL): GREEN OWNER COPY (FINAL): YELLOW INSPECTION COPY (INITIAL): PINK OWNER COPY (INITIAL): GOLD