IREDELL COUNTY HEALTH DEPARTMENT

Statesville Phone TR 3-7271 Mooresville Phone NO 3-1271

PERMIT TO INSTALL SEPTIC TANK

Permit No. 117 Permit Date 6-29-1972

Owner [redacted] Cransill Address Statesville

Installed By Adams Address Hiddnitte


Location of Property US 21 N to Cardinal Acres Lot 14

Tank		Capacity		Length of Lines		Fixtures	
Block	( )	1000	(✓)	225'	( )	No. of Baths	(2)
Precast	(✓)	1250	( )	250'	( )	Dishwasher	(no)
		1500	( )	Other 330'		Garbage Grdr.	(no)
		Other				Other	

NOTIFY HEALTH DEPARTMENT AT LEAST EIGHT HOURS BEFORE TANK IS TO BE INSPECTED.

Final Inspection 6-29-1972 Approved ( ) Disapproved ( )

Remarks Community well

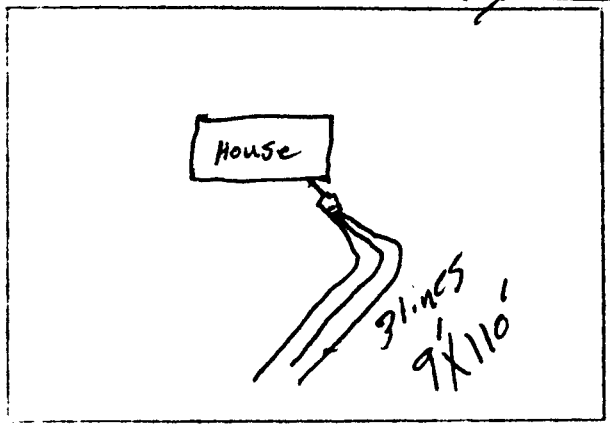

Sketch of Installation

J. C. Moore

Sanitarian