~~1100~~ 1100

IREDELL COUNTY HEALTH DEPARTMENT

STATESVILLE 704-878-5305 MOORESVILLE 704-664-5281

IMPROVEMENT PERMIT / AUTHORIZATION TO CONSTRUCT / OPERATION PERMIT / EXISTING SYSTEM INSPECTION

PERMIT# 077407 PIN# 4659 38 7977 DATE 11/9/98

OWNER OR CONTRACTOR PHILIP ~~onIZEL~~ Meizel PHONE: Business _____ Home 545-3842

ADDRESS 9707 BELLA MARINE DR. CHARLOTTE - NC 28227

LOCATION 21/115N - TR WESTMORELAND RD - TL CARDINAL LN - ON LT NEAREND 163 Cardinal Ln

SUBDIVISION CARDINAL ACRES BLOCK / SECTION _____ LOT 30 LOT AREA 1.48 AC SITE CLASS. ES DESIGN FLOW 360GPD L.T.A.R. 36 GPD/AC

Septic Tank: 1000 Gallons; STB CCC 555-1000 Date 12/14/98

Pump Tank: _____ Gallons; PT _____ Date _____

Pump Make: _____ Model _____ Serial No. _____

Nitrification Field: No Fields 1 Square Feet 900 Linear Feet 300

No Lines 3@100 Trench Width 36" Max Trench Bottom Depth 36" Gravel Depth N/A

☒ New System ☐ Repair System Type: I, II, ⓘ, IV, V, VI

System Description: GRAVITY CHAMBERS & LINES

Repair System Description: GRAVITY DANEC

Maintenance Agreement Required: ☐ Yes ☒ No

☒ House/Mod. Home ☐ Mobile Home ☐ Business ☐ Other

No. Bedrooms 3 No. Bathrooms 2 No. Employees ____


☐ Slab ☒ Crawl Space ☐ Basement w/plumbing ☐ Basement wo/plumbing

Water Supply: ☒ Individual ☐ Public ☐ Community


Comments:/Conditions: Lines & D-Box Checked 11/6/98 Tank was only 23 Days old at time of initial inspection therefore could not approve. MD

Comments:/Conditions: Checked Tank 1/12/99 MD

INITIAL SITE SKETCH 1"=40'

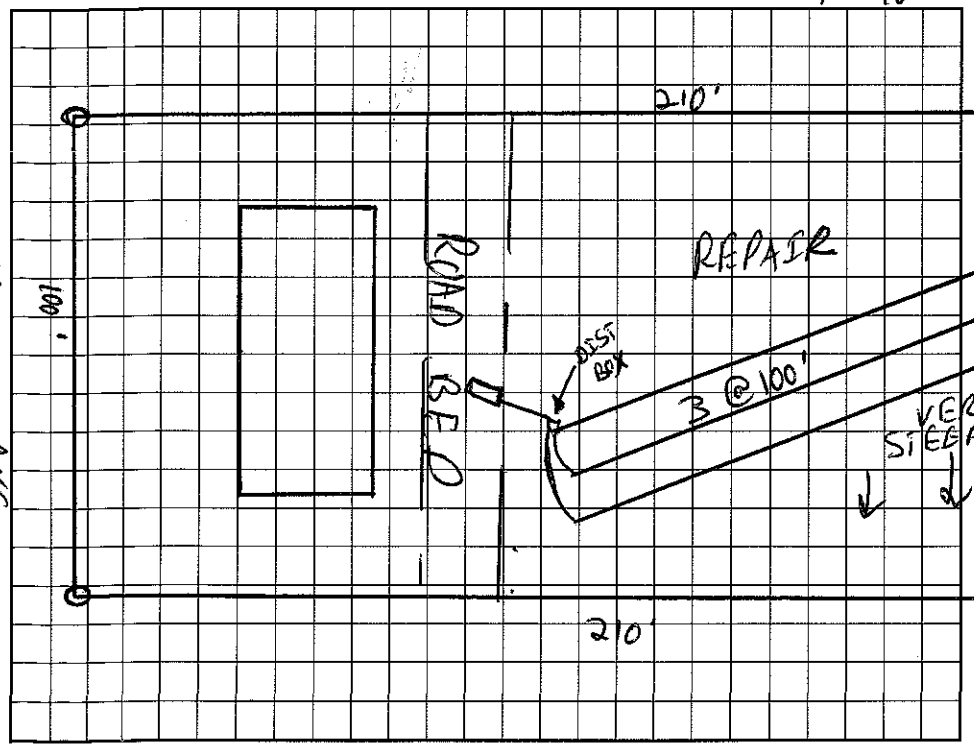

AS BUILT SKETCH

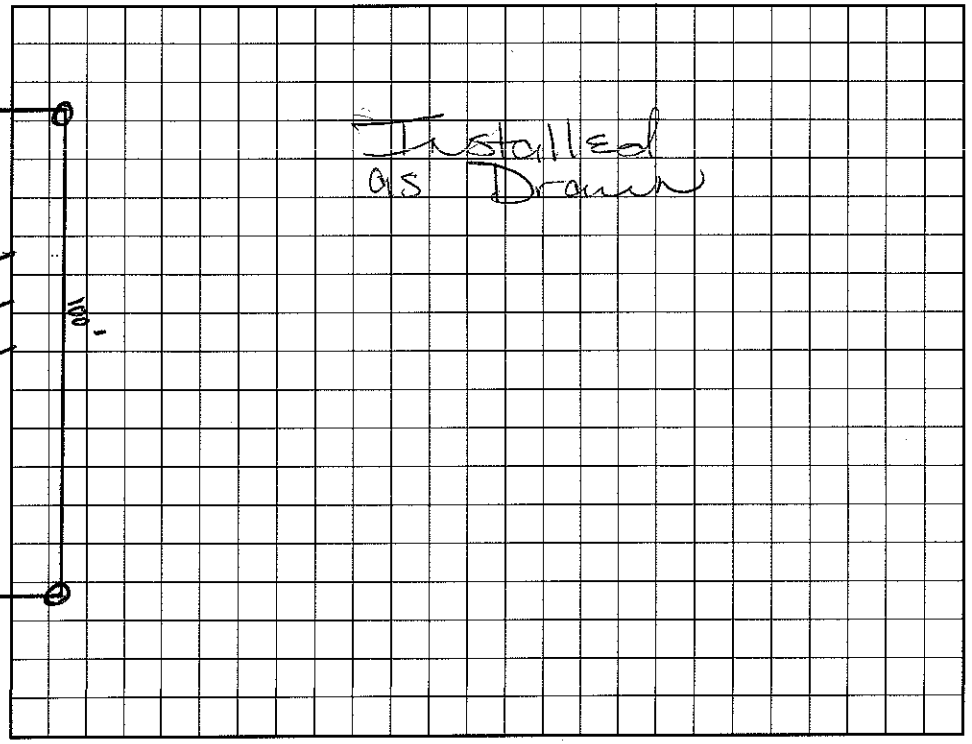

I understand that this permit can be suspended or revoked if any false information is supplied toward securing the permit/any unauthorized changes are made to the site/any unauthorized changes are made in the installation of the system. Improvement Permit with plat valid without expiration. Improvement Permit with site plan valid for sixty months. Authorization to Construct is valid for a period equal to that of Improvement Permit – not to exceed sixty months.

Signed: _____ date 11/12/98

Improvement Permit by: C. Gaither RS date 11/9/98

Authorization to Construct by: C. Gaither RS date 11/9/98

Installed by: Gary Miller

Operation Permit by: ~~Mark~~ H. L. Dotson RS date 1/12/99

Existing System Inspection by: _____ date _____

HEALTH DEPT. COPY: WHITE INSPECTION COPY (FINAL): GREEN OWNER COPY (FINAL): YELLOW INSPECTION COPY (INITIAL): PINK OWNER COPY (INITIAL): GOLD

