IREDELL COUNTY HEALTH DEPARTMENT

Paid 250.00 DT

STATESVILLE 704-878-5305 MOORESVILLE 704-664-5281

IMPROVEMENT PERMIT / AUTHORIZATION TO CONSTRUCT / OPERATION PERMIT / EXISTING SYSTEM INSPECTION

PERMIT# 90518 PIN# 4659 43 9951 DATE 9/18/00

OWNER OR CONTRACTOR Di Dio Canine CC PHONE: Business 664-1311 Home

ADDRESS 139 Di Dio Cir Mooresville NC 28115

LOCATION 21 N + R Di Dio Cir on Lt

SUBDIVISION — BLOCK / SECTION — LOT — LOT AREA 8.37 SITE CLASS. PS DESIGN FLOW 1125 L.T.A.R. 0.55

Septic Tank: 2000 Gallons; STB 56 Date 1/28/01

Pump Tank: 2000 Gallons; PT 125 Date 2/3/01

Pump Make: Zoeller Model N163 Serial No.

Nitrification Field: No Fields 2 Square Feet 3213 Linear Feet 1071

No Lines 14 Trench Width 36" Max Trench Bottom Depth 36" Gravel Depth 12"

☒ New System ☐ Repair System Type: I, II, III, IV, V, VI

System Description: Pump & gravel trench

Repair System Description: Some

Maintenance Agreement Required: ☐ Yes ☒ No

☐ House/Mod. Home No. Bedrooms

☐ Mobile Home No. Bathrooms

☒ Business No. Employees 5

☐ Other

☐ Slab ☐ Crawl Space ☐ Basement w/plumbing ☐ Basement wo/plumbing

Water Supply: ☒ Individual ☐ Public ☐ Community


Comments:/Conditions:

* Flow Divider on the 2-50' Lines
+ See Attached for Addition comments


REPAIR

Comments:/Conditions:

INITIAL SITE SKETCH

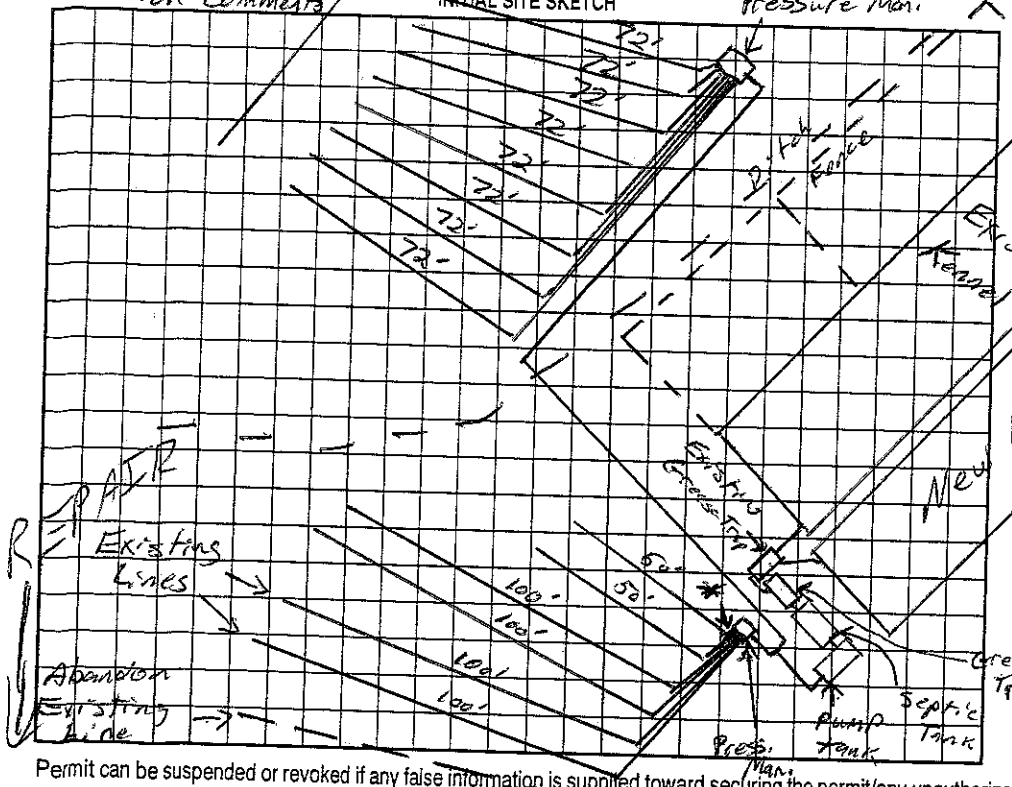

AS BUILT SKETCH

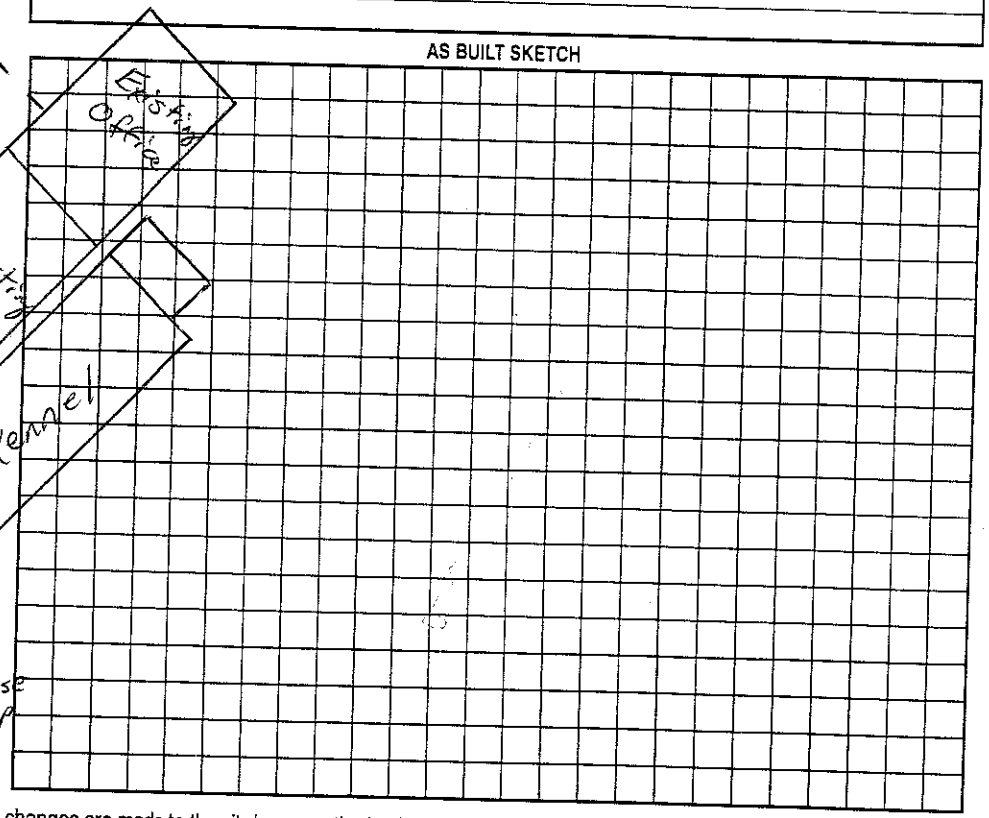

Permit can be suspended or revoked if any false information is supplied toward securing the permit/any unauthorized changes are made to the site/any unauthorized changes are made in the installation of the system. Improvement Permit with plat valid without expiration. Improvement Permit with site plan valid for sixty months. Authorization to Construct is valid for a period equal to that of Improvement Permit – not to exceed sixty months.

Signed: Bob Purdy date 9-25-00

Improvement Permit by: RST date 9/18/00

Authorization to Construct by: RST date 9/18/00

Installed by: Piedmont Septic

Operation Permit by: RS date 4/10/02

Existing System Inspection by: date

HEALTH DEPT. COPY: WHITE OWNER COPY (FINAL): YELLOW OWNER COPY (INITIAL): PINK