4659-44-1632

IREDELL COUNTY HEALTH DEPARTMENT

STATESVILLE 704-878-5305 MOORESVILLE 704-664-5281

IMPROVEMENT PERMIT / CERTIFICATE OF COMPLETION / OPERATION PERMIT / EXISTING SYSTEM INSPECTION

PROPERTY DESCRIPTION NO. 21921 DATE 9/1/95 TAX MAP NO. 4E 4A 28 Watershed: ☐ Yes ☒ No

OWNER OR CONTRACTOR Willie Dean Middleton PHONE: Business _____ Home 871-0369

ADDRESS PO Box 1071 Mooresville, NC, 28115

LOCATION 115-21N TR ON FREEZE RD, TO 5th LOT ON (R)

SUBDIVISION FREEZE CROSSING BLOCK / SECTION _____ LOT 28 LOT AREA 150 x 203 SITE CLASS. PS DESIGN FLOW 360 L.T.A.R. .3

Septic Tank: 1000 Gallons; STB 794 Date 9/1/95
Pump Tank: _____ Gallons; PT _____ Date _____
Pump Make: _____ Model _____ Serial No. _____
Nitrification Field: No Fields 1 Square Feet 1200 Linear Feet ~~300~~
No Lines 3 Trench Width 36" Max Trench Bottom Depth 36"

☒ New System ☐ Repair System Type: I, II, (III) IV, V, VI
System Description: GRAV INFILTRATOR
Repair System Description: SAME
Maintenance Agreement Required: ☐ Yes ☒ No
Gravel Depth 6"3/4 IND ☐ Slab ☒ Crawl Space ☐ Basement w/plumbing ☐ Basement wo/plumbing


☐ House/Mod. Home No. Bedrooms 3
☒ Mobile Home D/W No. Bathrooms 2
☐ Business No. Employees ____
☐ Other _____

Water Supply: ☒ Individual ☐ Community ☐ Public

Comments: * 25% reduction of for INFILTRATOR USE
SPEED LEVELERS IN DIST BOX.
LINES ON SLOPE CONTOUR

Comments:
installed as shown on Imp. Permit

INITIAL SITE SKETCH

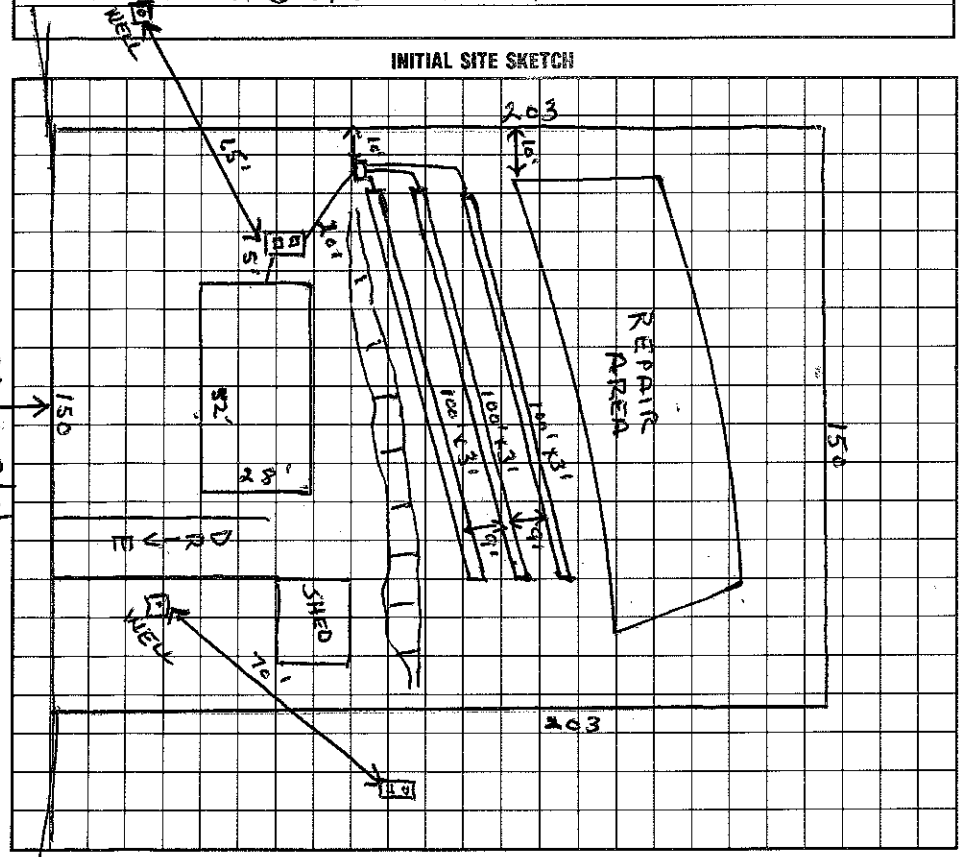

AS BUILT SKETCH

I understand that this permit can be suspended or revoked if any false information is supplied toward securing the permit/any unauthorized changes are made to the site/any unauthorized changes are made in the installation of the system.

Signed: * Dean Middleton

Improvement Permit by: Wesley Sparks RS, date 9/1/95

Existing System Inspection by: _____ date _____

Installed by: Dennis Gaither

Certificate of Completion by: Wesley Sparks RS, date 9/29/95

Operation Permit by: _____ date _____

HEALTH DEPT. COPY: WHITE INSPECTION COPY (FINAL): GREEN OWNER COPY (FINAL): YELLOW INSPECTION COPY (INITIAL): PINK OWNER COPY (INITIAL): GOLD